


T.5 & 6S.R.6W. W.M.

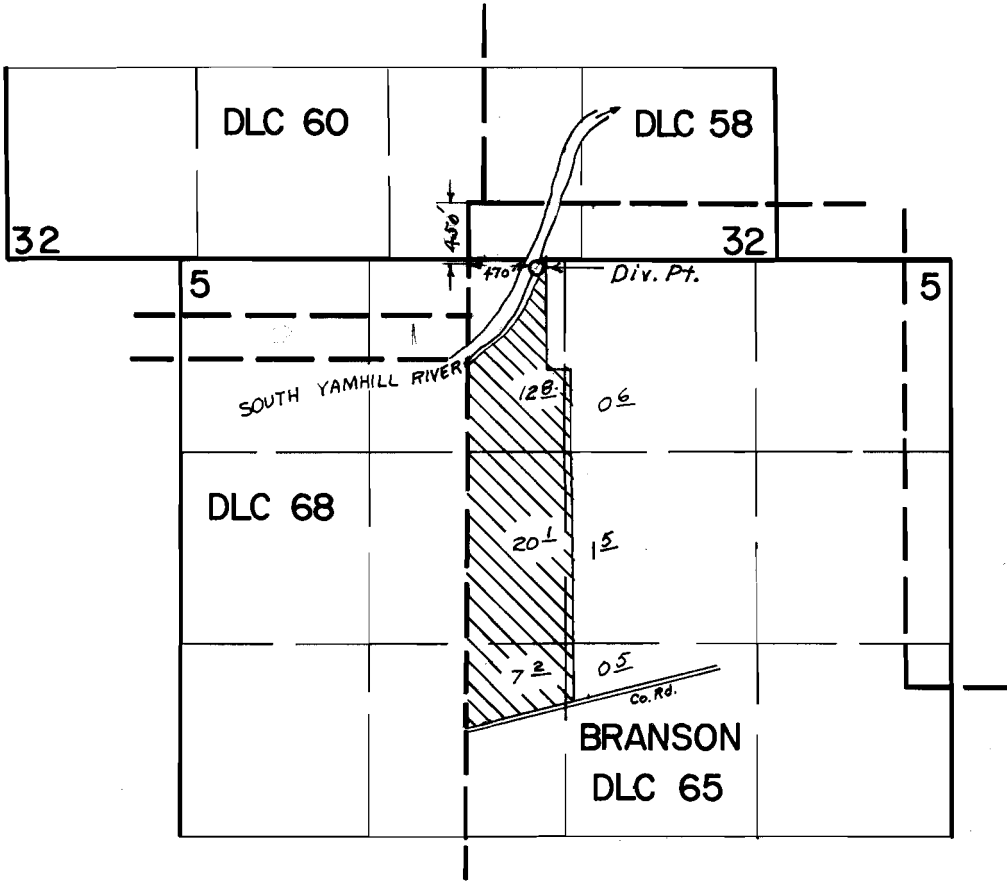

FINAL PROOF SURVEY UNDER

Application No. 44045 Permit No. 32916
IN NAME OF

HAROLD BUEL & JOHN DEJONG

Surveyed MAY 26 1972, by L. GOULD