


# T.8 & 9 S.R.5 & 6 W.W.M.

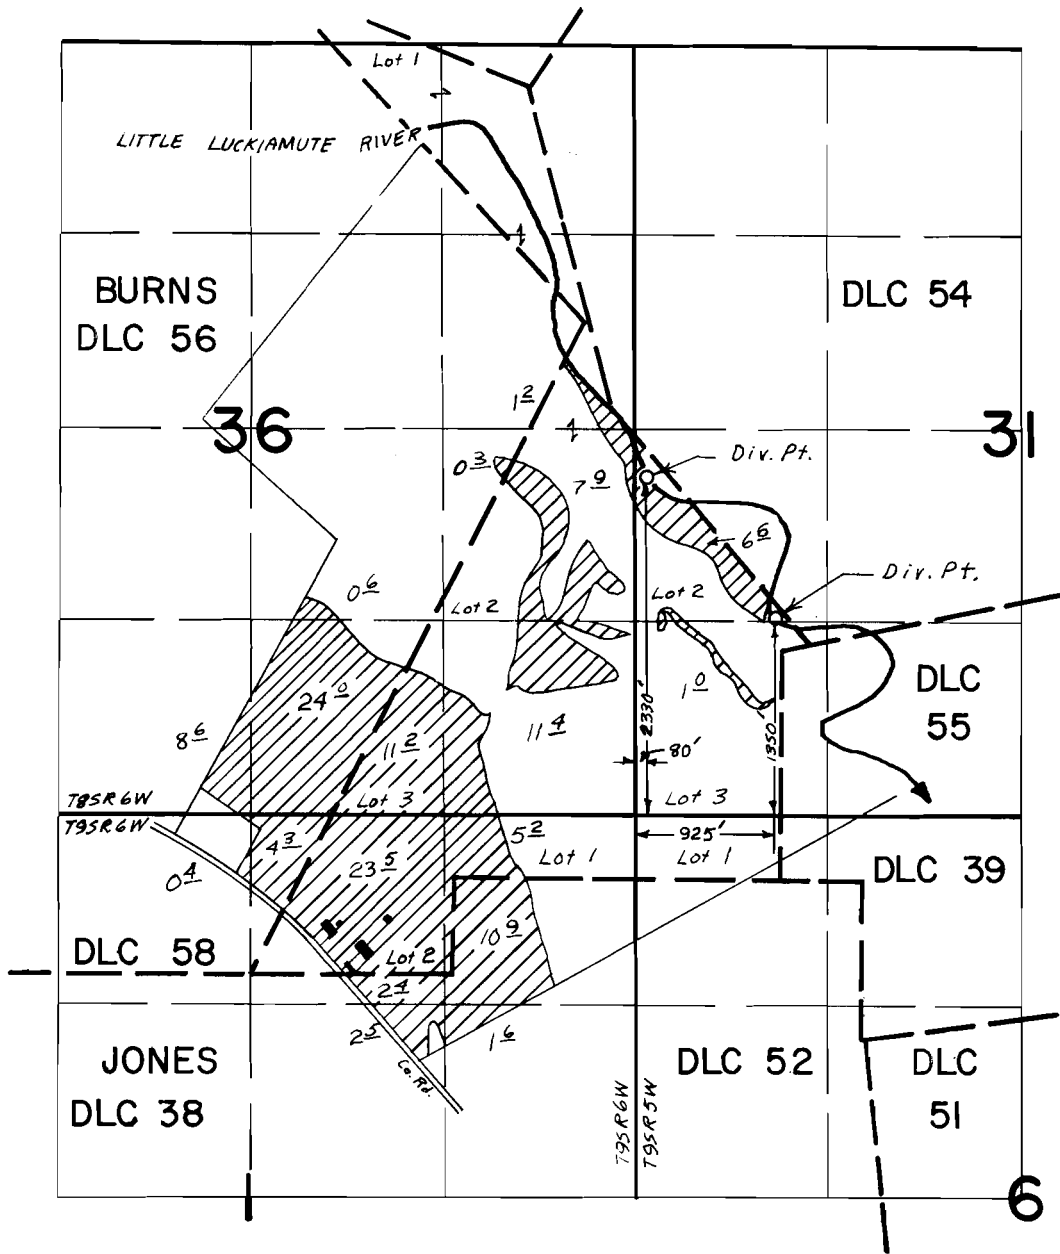

## FINAL PROOF SURVEY UNDER

Application No. 45755 Permit No. 34153  
IN NAME OF

J. L. HENDRICKSON

Surveyed NOV 21 19 72, by L. GOULD