


T.6 S., R.5 W., W.M.

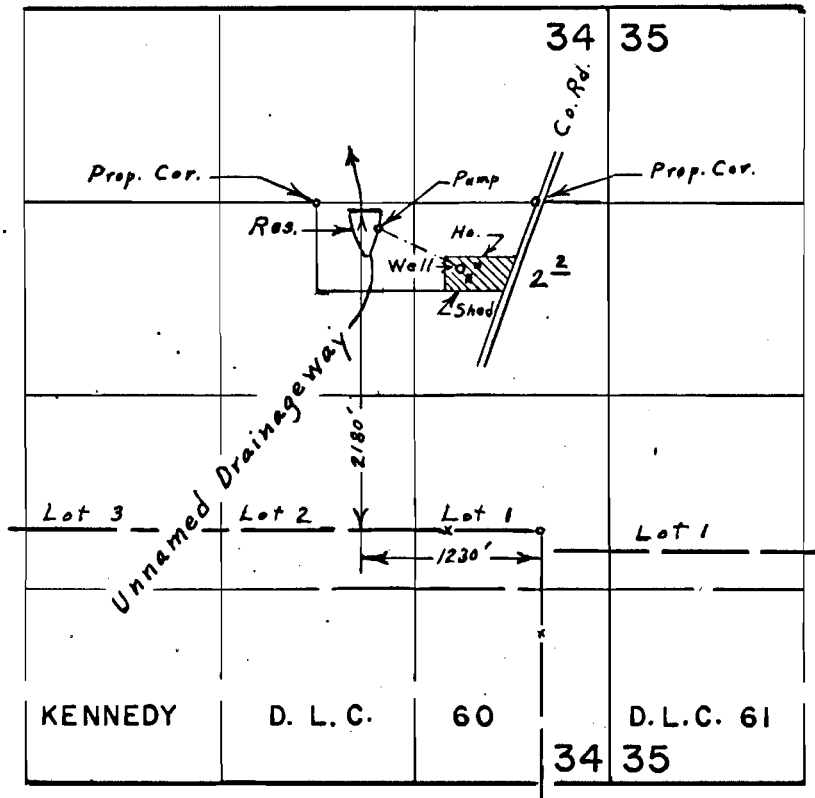

FINAL PROOF SURVEY
UNDER

R-45846 R - 5449
 45847 34228
 R-48016 R - 5827
 Application No. 48017 Permit No. 36012
 IN NAME OF

HAROLD G. LARSON

Surveyed Nov. 14, 1972, by L. E. Gould