


T. 7 S. R. 4 W. W. M.

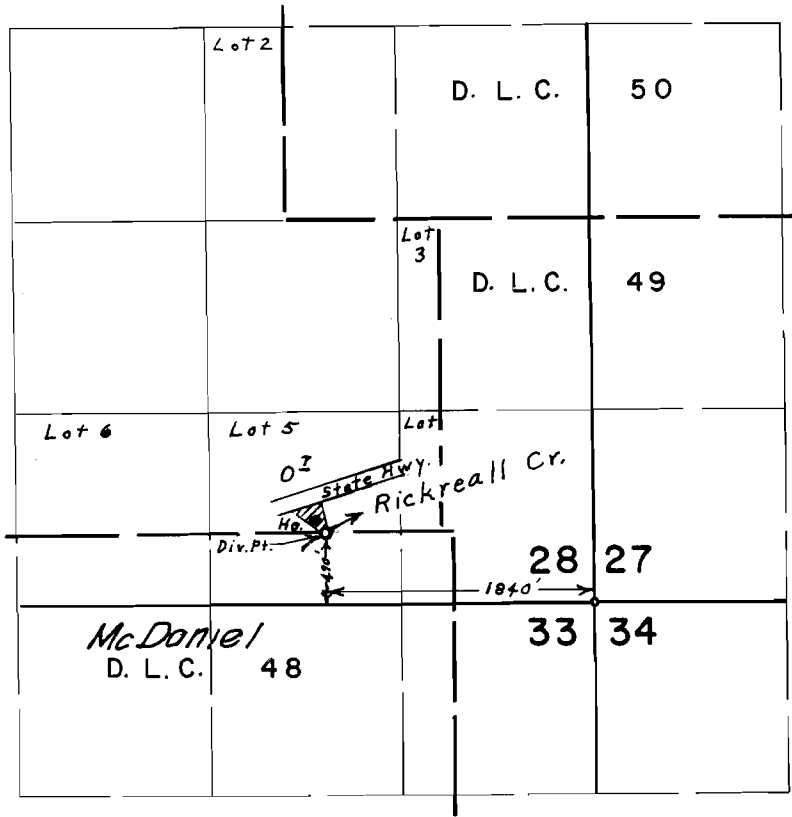

FINAL PROOF SURVEY UNDER

Application No. 46303 Permit No. 34583
IN NAME OF

LYLE R. BURNHAM

Surveyed April 6, 1972, by L. E. Gould