T. 7 S. R. 4 W. W.M.

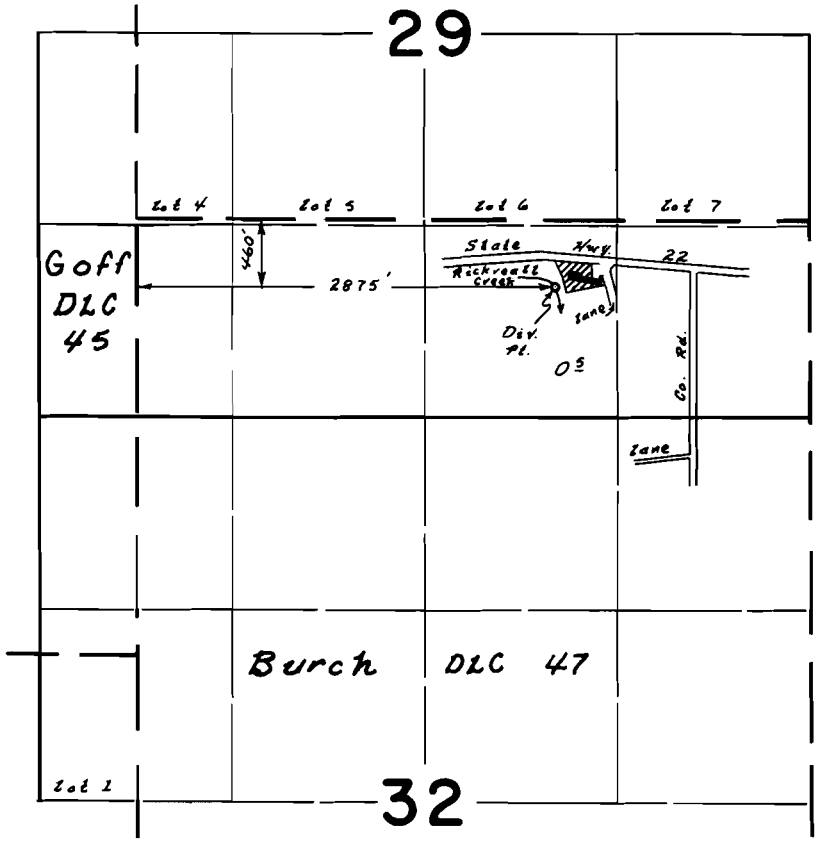

FINAL PROOF SURVEY
UNDER

Application No. 46 329 Permit No. 34614
IN NAME OF
William L. Braman

Surveyed 16 June 19.72, by L. E. Gould

Photo DFP-2D-102 & 1972-T W.E.O.