


T. 6 S. R. 7 W. W.M.

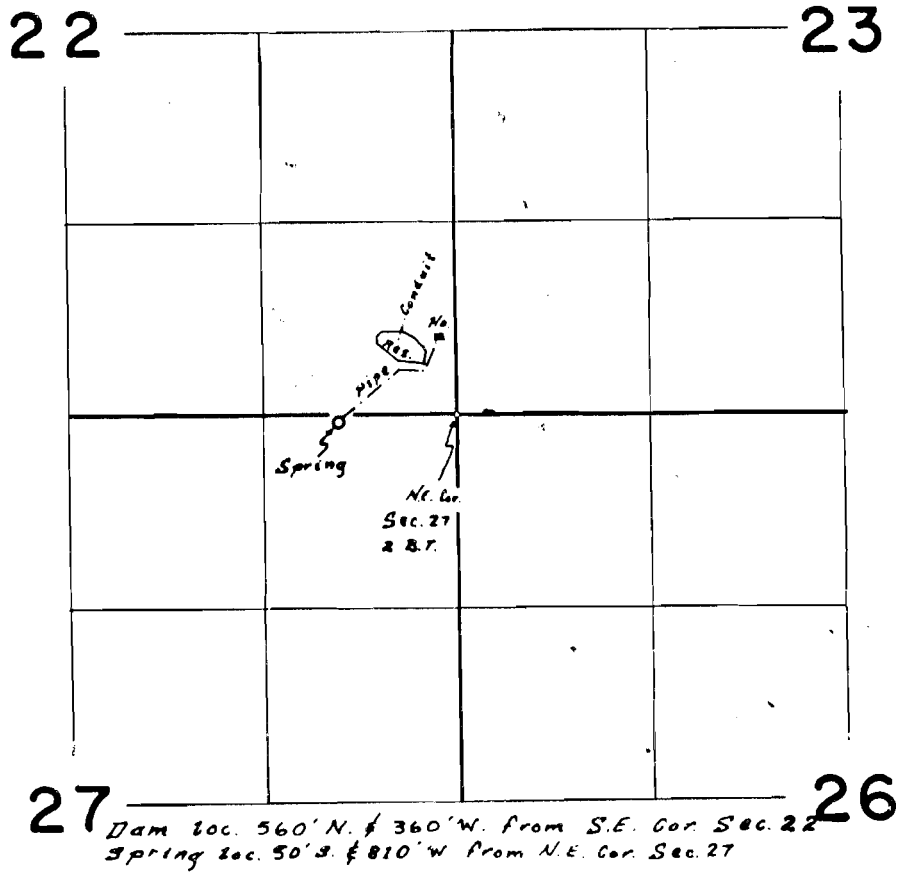

FINAL PROOF SURVEY
UNDER

R-42381 R-4853
Application No. 46542 Permit No. 34772...
IN NAME OF

Donald Bailey

Surveyed 13 June, 1972, by L.E. Gould...