


# T.6 S., R.7 W., W.M.

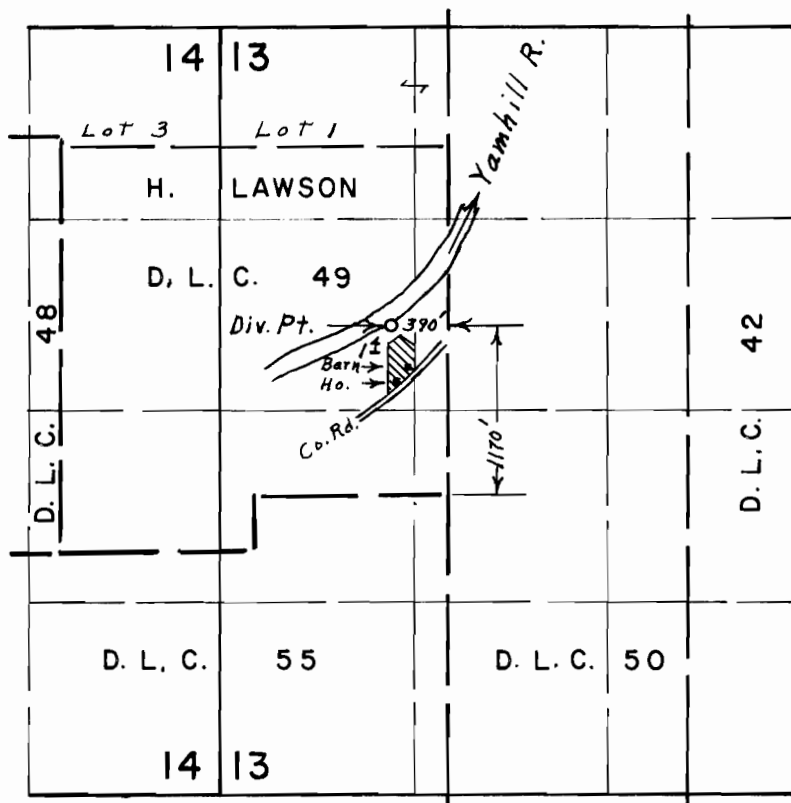

## FINAL PROOF SURVEY UNDER

Application No. 46919 Permit No. 34949  
IN NAME OF

STANLEY F. & VENICE M. KOUBA

Surveyed Nov. 15, 1972, by L. E. Gould