


T. 7 S. R. 4 & 5 W. W.M.

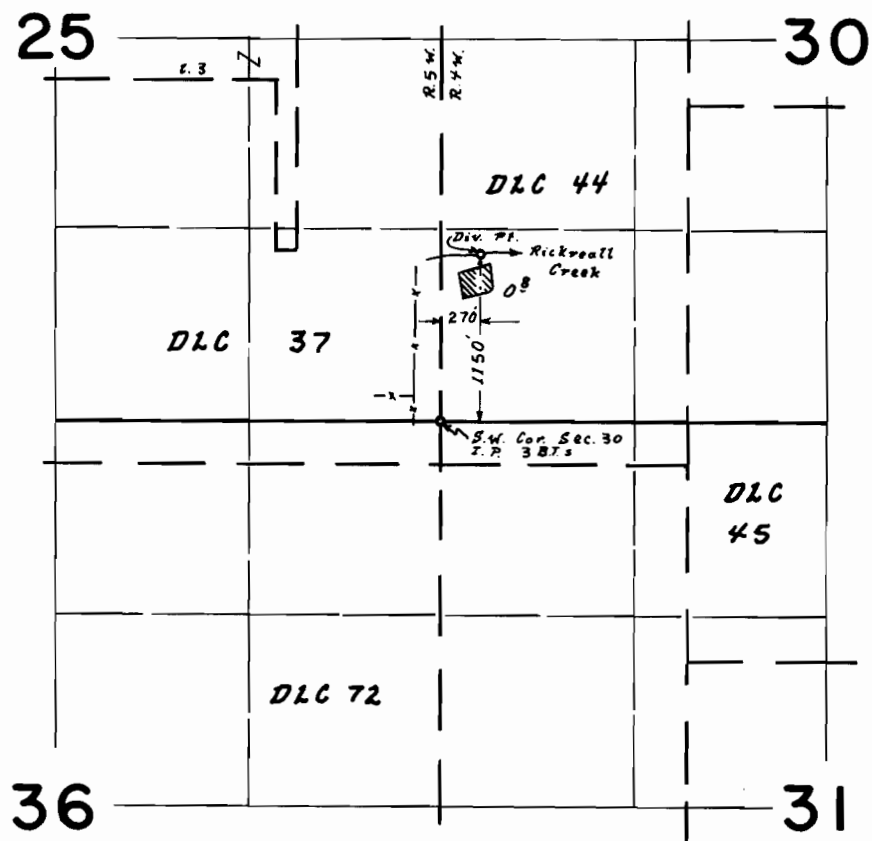

FINAL PROOF SURVEY  
UNDER

Application No. 46876 Permit No. 35045

IN NAME OF

*Hubert E. Grimsbo*

Surveyed 16 June 1972 by L. E. Gould