


T.6 S.R.8W. W.M.

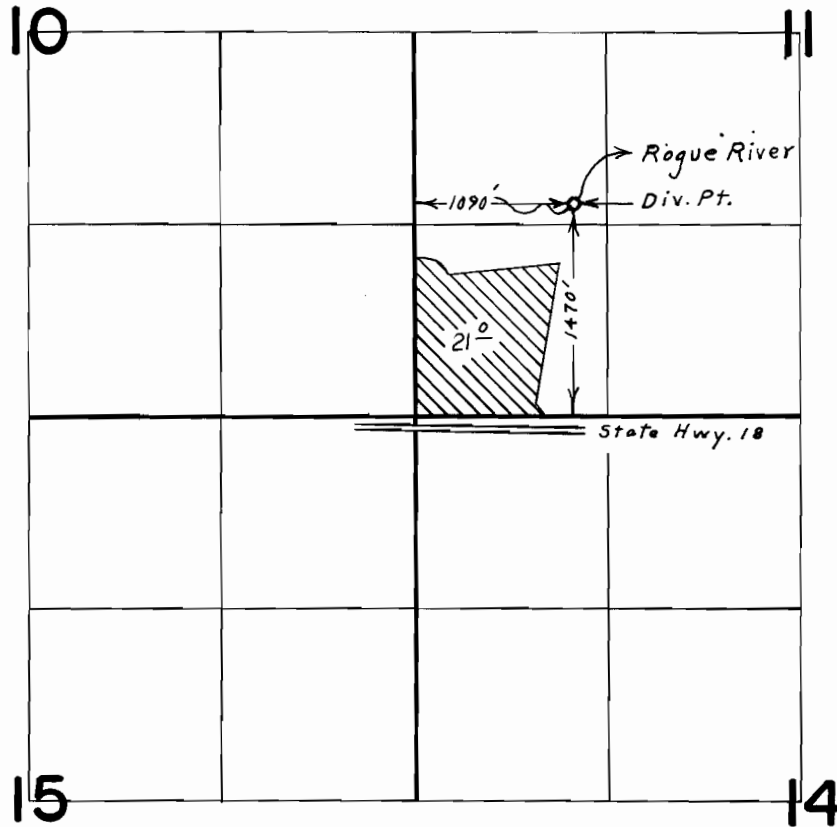

FINAL PROOF SURVEY
UNDER

Application No. 46880 Permit No. 35049

IN NAME OF

KEITH BUSBOOM

Surveyed SEPT 28 1972, by L. GOULD