


T. 6 S. R. 7 W. W.M.

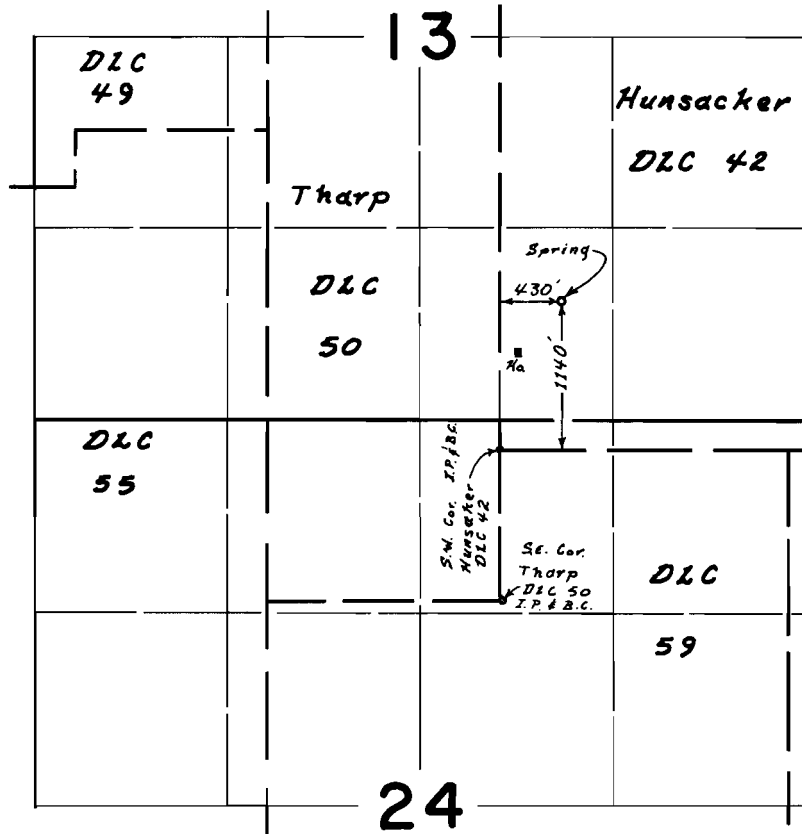

**FINAL PROOF SURVEY**  
UNDER

Application No. 47003 Permit No. 35164

IN NAME OF

*Frank T. Girard*

Surveyed 27 Sept. 1972, by L. E. Gould