


T. 6 S., R. 5 W., W.M.

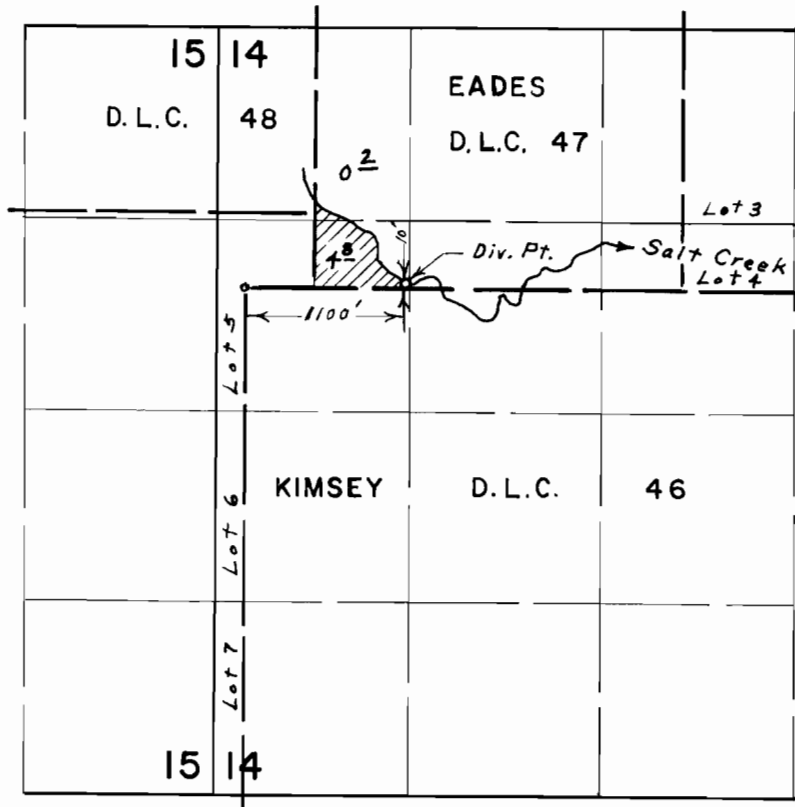

FINAL PROOF SURVEY
UNDER

Application No. 47483 Permit No. 35565
IN NAME OF

JACOB BAKKER

Surveyed April 28, 1972, by L. E. Gould