


G-2670  
39205

# T.I.S.R.32E.W.M.

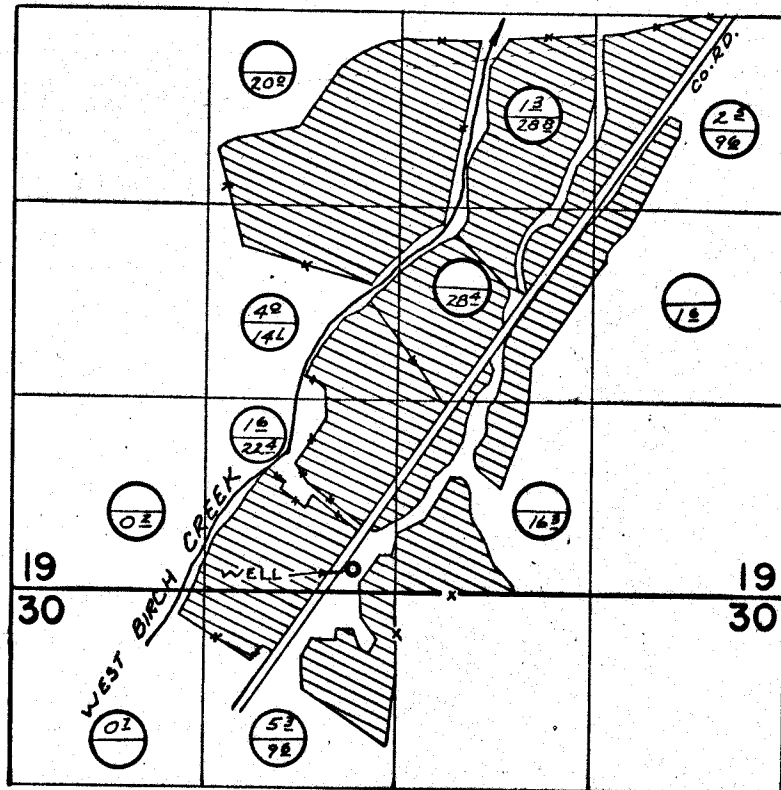

WELL LOC: 170' N. & 300' W FROM S 1/4 COR. SEC. 19

○ — PRIMARY  
● — SUPPLEMENTAL

## FINAL PROOF SURVEY UNDER

Application No. G-2672 Permit No. G-2670  
IN NAME OF

ARNOLD G. HOEFT  
JUNE 22, 23, 1971 G. BACA  
Surveyed AUG. 20, 1964, by C.V. GARDNER