


T. 2 S. R. 5 W. W. M.

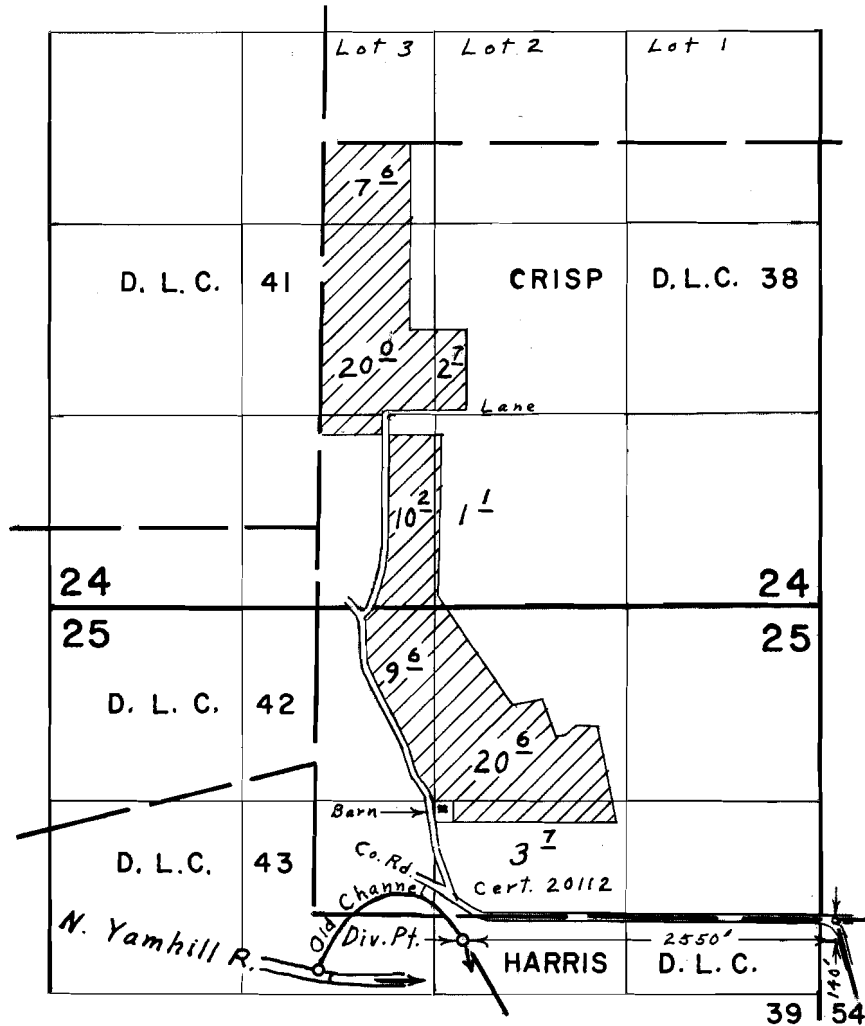

FINAL PROOF SURVEY UNDER

Application No. 40150... Permit No. 29929
IN NAME OF

DEL and DIXIE COURSEY

Surveyed July 7, 1971, by L. E. Gould