


T.2 & 3 S.R.5 W.W.M.

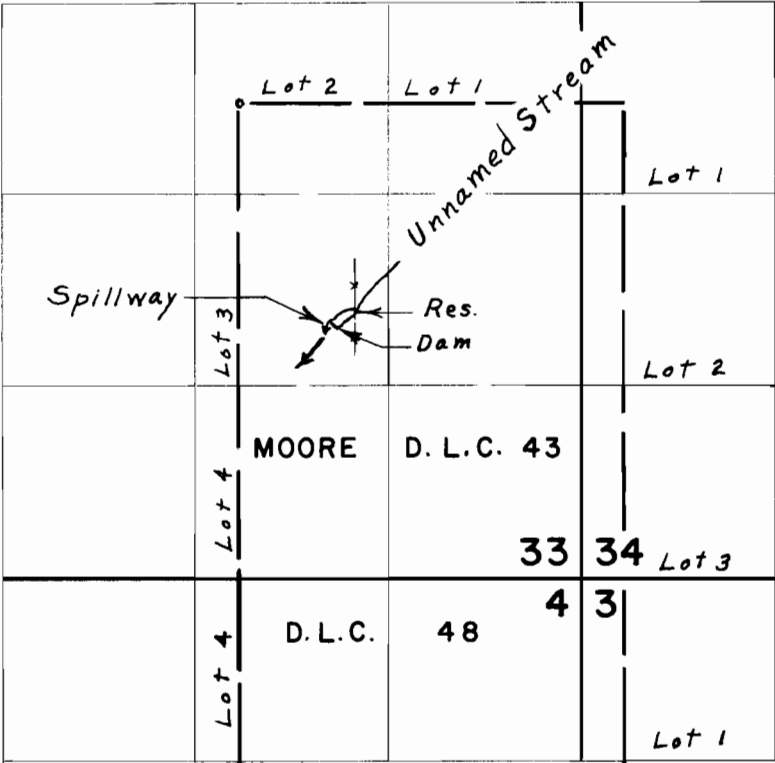

Div. Pt. located 1540' S. & 650' E. from N.W. Cor. Moore D.L.C. 43

FINAL PROOF SURVEY
UNDER

R-45287 R-5343
Application No. 45288 Permit No. 33817
IN NAME OF

W. A. COON

Surveyed Nov. 15, 1971, by L. E. Gould