


T.10S.R.30E.W.M.

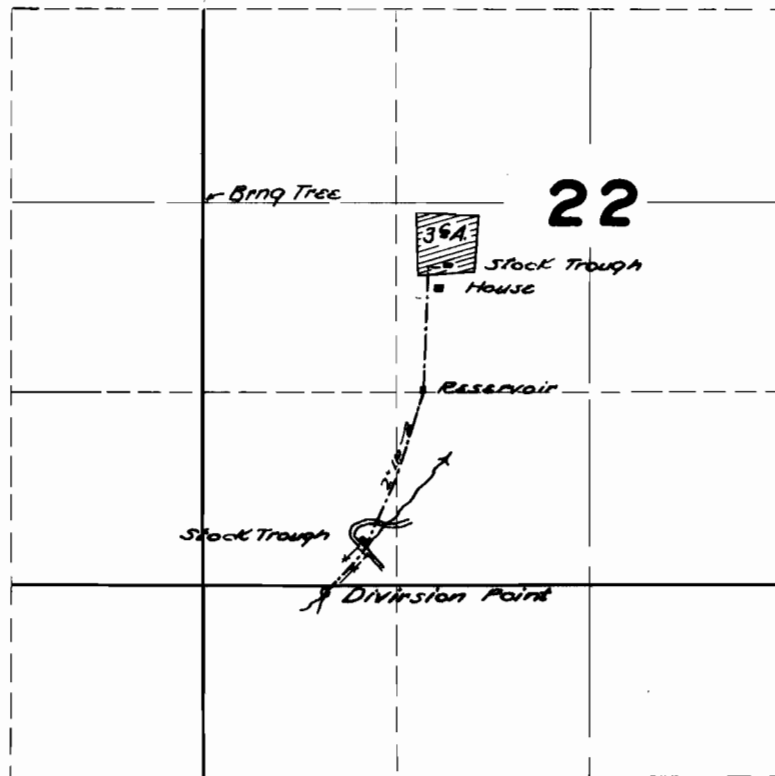

FINAL PROOF SURVEY

UNDER

Application No. **18694** Permit No. **14377**

IN NAME OF

JOHN L. CARTER

Surveyed **NOV. 2** 1949, by **H.L. COFFMAN**.