


T.11S.R.3W. & T.12S.R.2W. W.M.

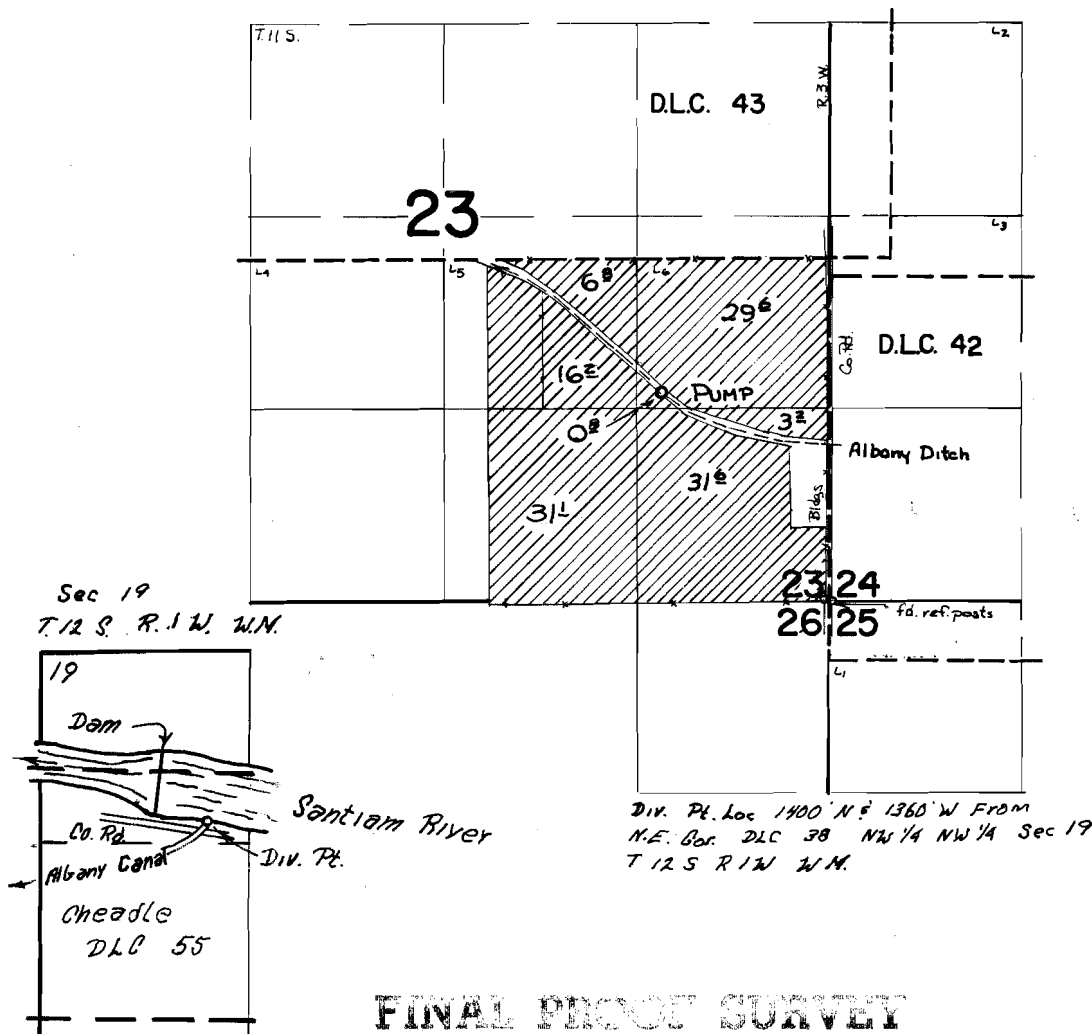

Application No. 40907 Permit No. 30433
IN NAME OF

JACOB LEICHTY

Surveyed 2 APR. 1970, by D.R. BUELL