


T. 6 S. R. 5 W. W. M.

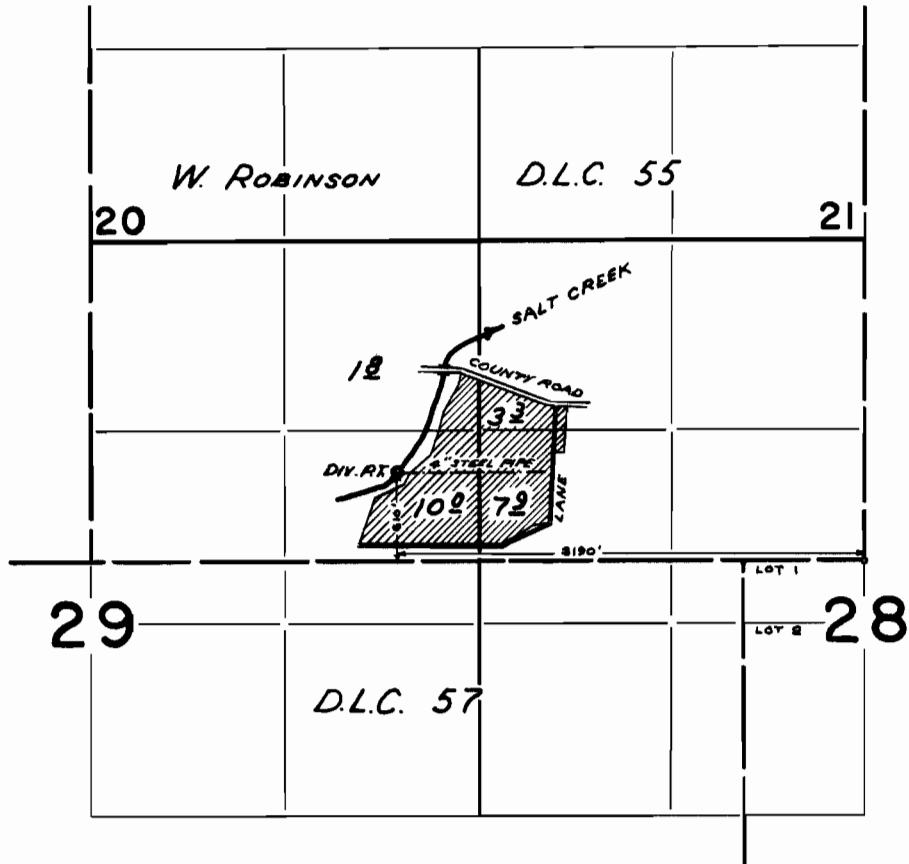

FINAL PROOF SURVEY
UNDER

Application No. 13191 Permit No. 9442
IN NAME OF

Joe & Mina Van Well

Surveyed JUL. 27 1965, by C. GARDNER