


T.5S.R.3W.W.M.

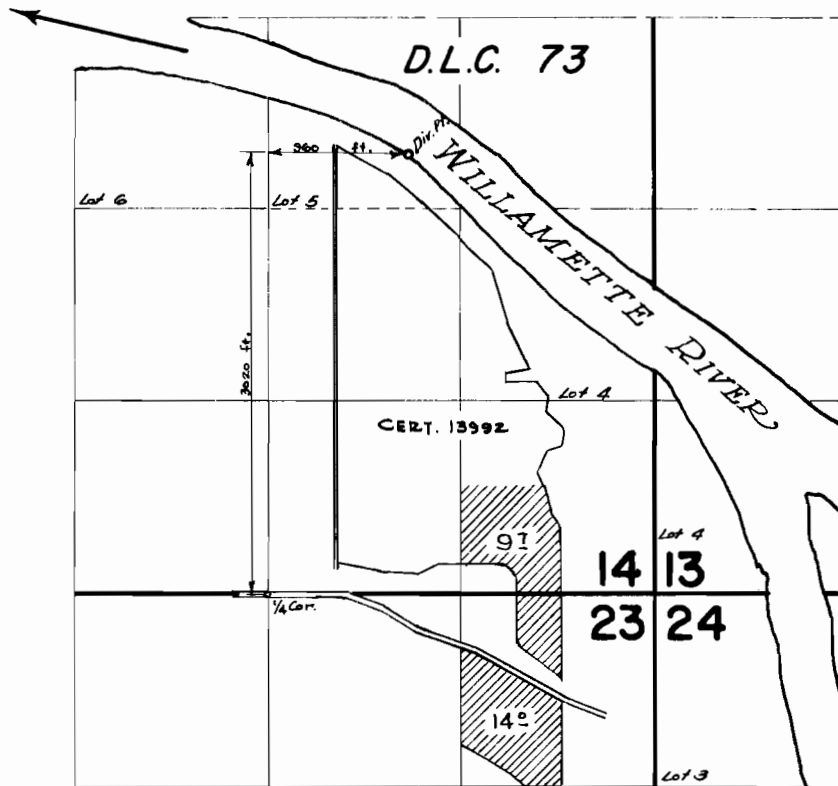

FINAL PROOF SURVEY UNDER

Application No. 37186... Permit No. 27690
IN NAME OF

ESTATE OF U. S. ALDERMAN

Surveyed July 3, 1963, by *R. Johnson*
& August 24, 1964