


T1N. R.4 W. W.M.

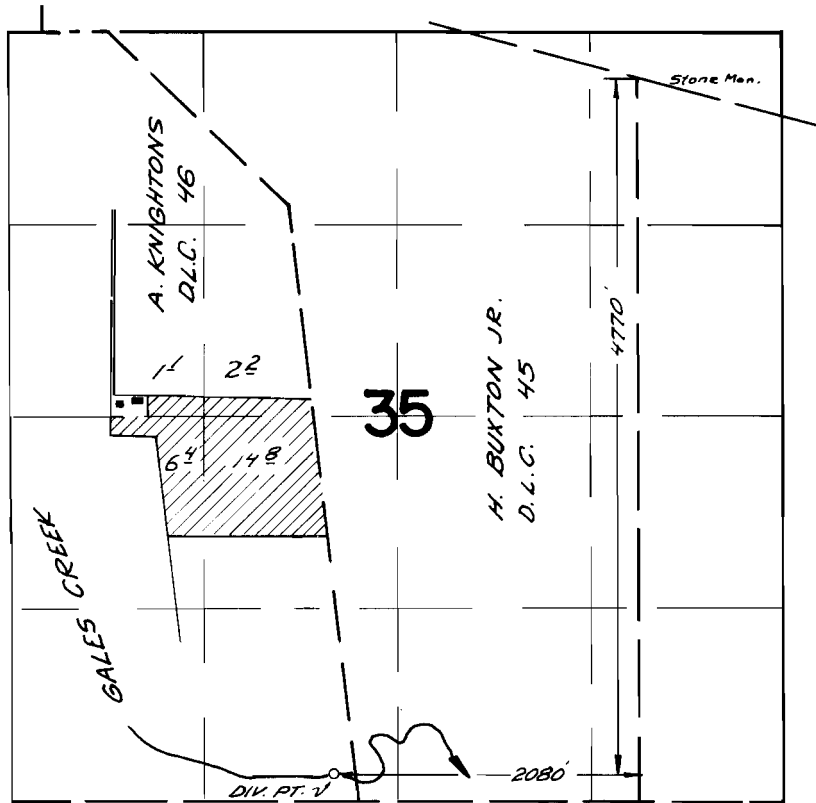

FINAL PROOF SURVEY UNDER

Application No. 42750 Permit No. 31959
IN NAME OF

W. G. KRIEGER by DALE McCULLOCH

Surveyed Jan 18 1968, by V. Garner