T.6S.R.7W.W.M.

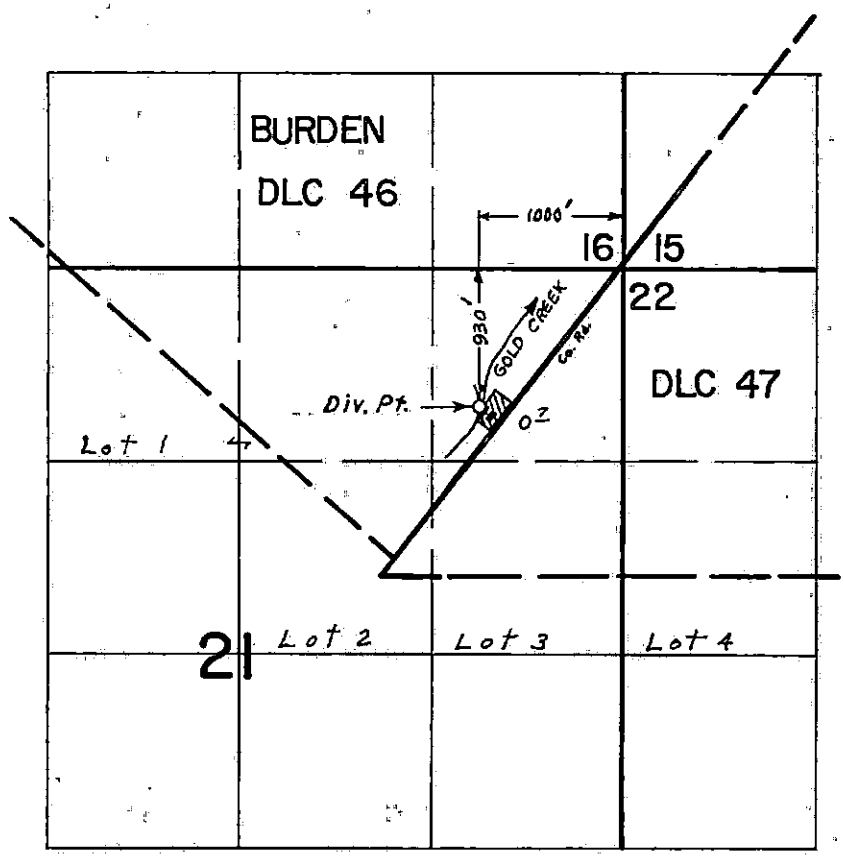

FINAL PROOF SURVEY
UNDER

Application No. ..... Permit No. TRANSFER NO. W-136

IN NAME OF

W.E. & M.V. WOODEN

Surveyed SEPT 27 19 72, by L. GOULD

DFP-3LL-45 D.C.