


T.25S. R.6 W.W.M.

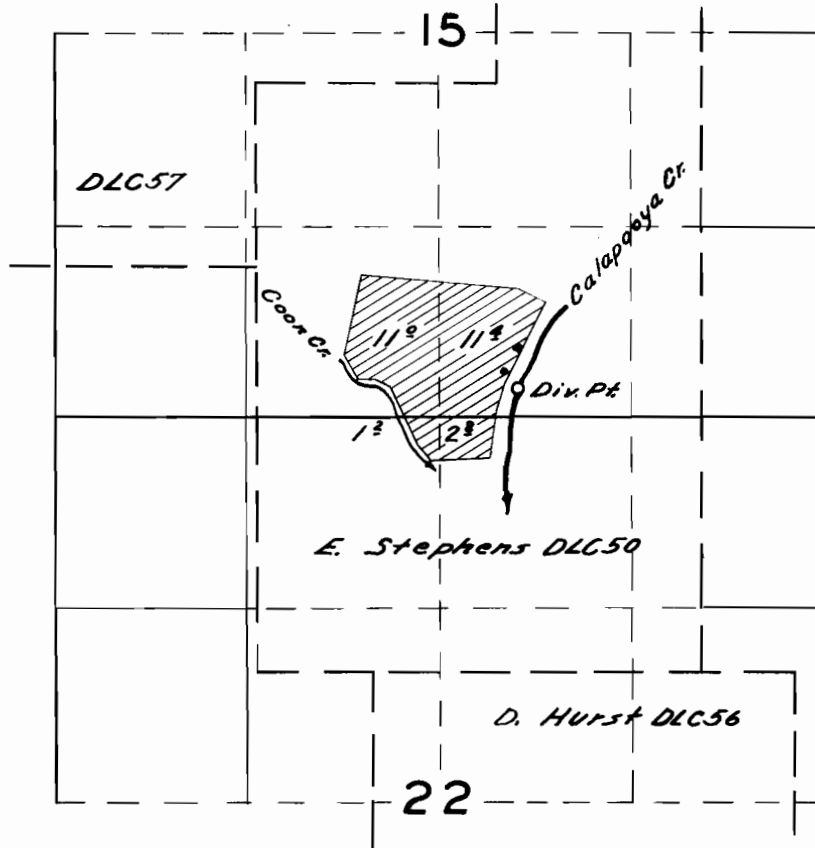

**FINAL PROOF SURVEY**

UNDER

Application No. *25088* Permit No. *19747*...

IN NAME OF

*Walter R. Davis*

Surveyed *Aug. 22*, 1956., by *C. O. Bartels*...