


T.22S. R.5W.W.M.

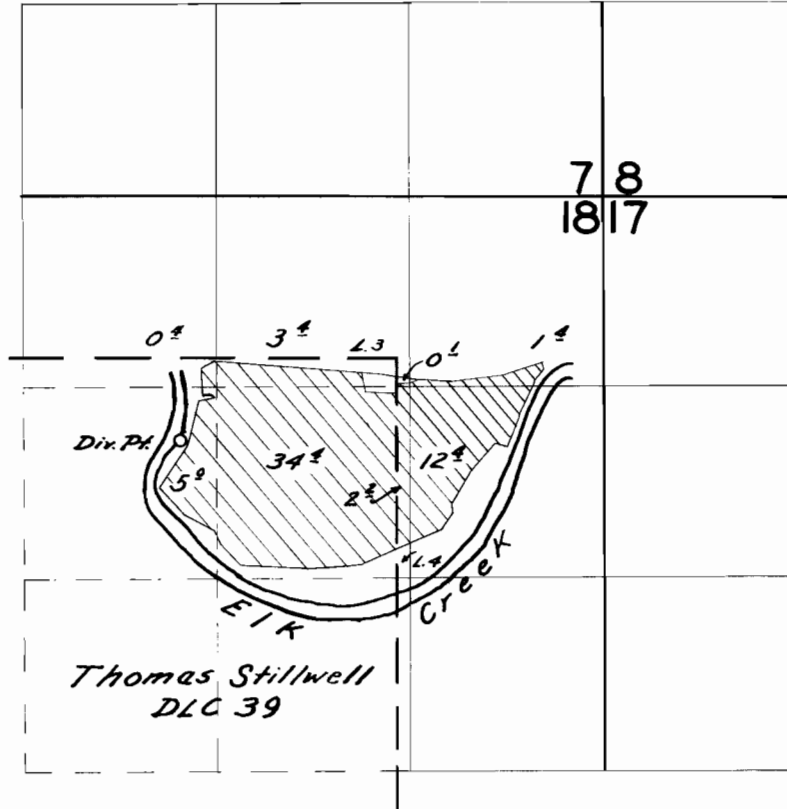

FINAL PROOF SURVEY

UNDER

Application No. 25093 Permit No. 19749
IN NAME OF

George Churchill

Surveyed June 26 1956 by *C.O. Bartels*