


T.10S.R.3W.W.M.

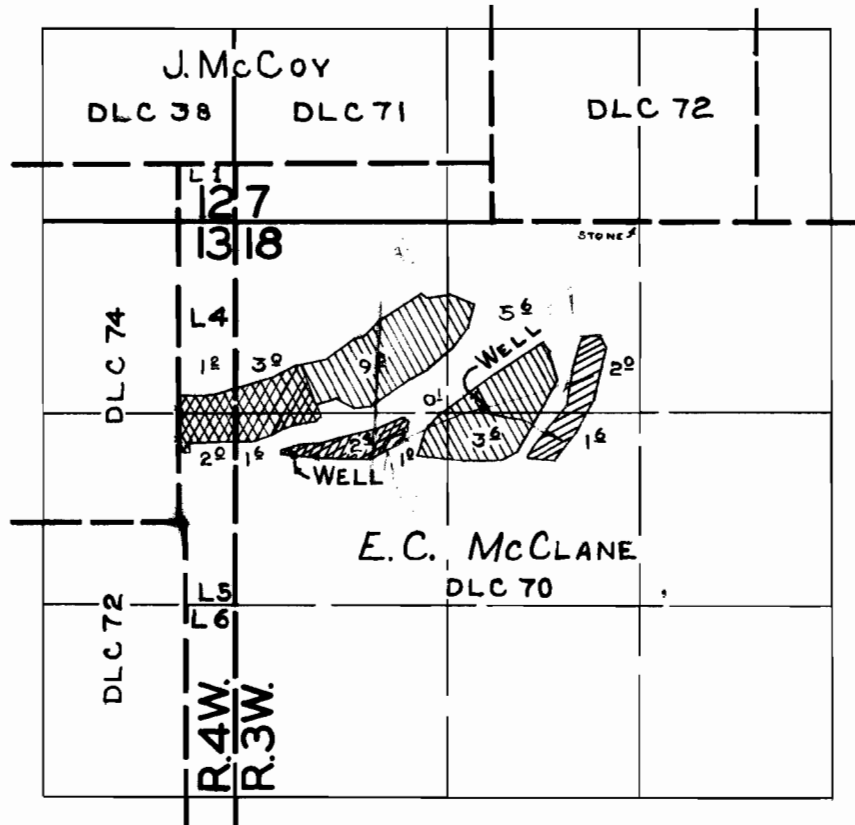

FINAL PROOF SURVEY UNDER

G-143 G-42
 G-722 G-639
 Application No. G-1289 Permit No. G-1133
 IN NAME OF



..... GEORGE E. & DOROTHY M. WEBER

Surveyed JUNE 22:23 1960, by M. BISH.....