T.7&8S. R.5W.W.M.

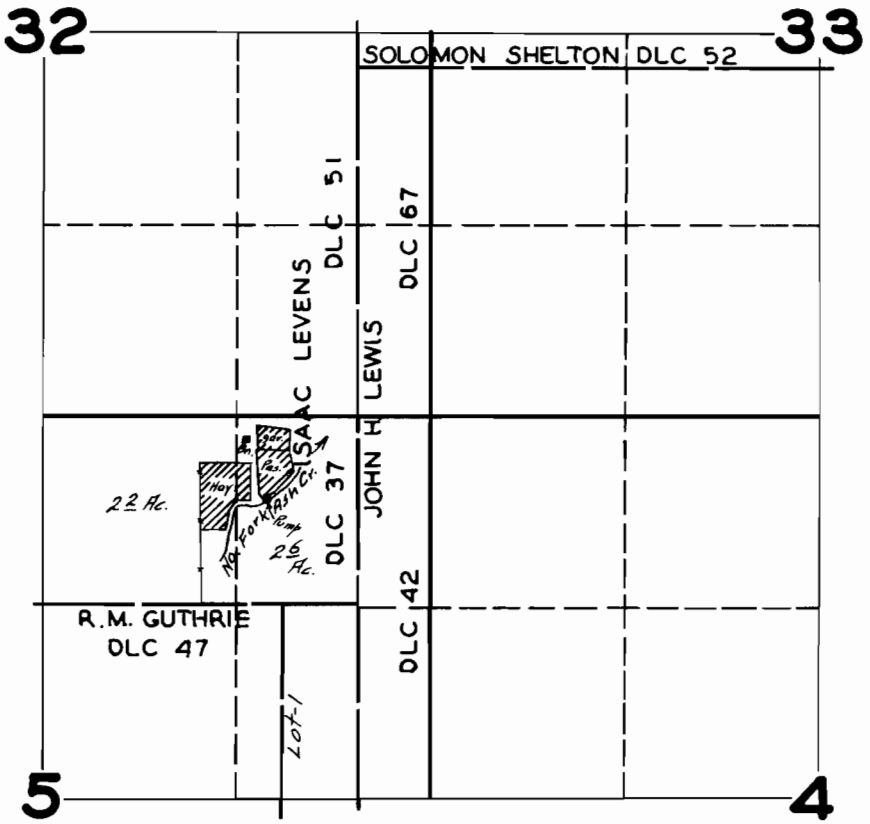

FINAL PROOF SURVEY

UNDER

Application No. 18110 Permit No. 13764

IN NAME OF

DEAN HELMS

Surveyed JULY 29 1944, by

1944 - E