


T. 8 S., R. 39 E., W.M.

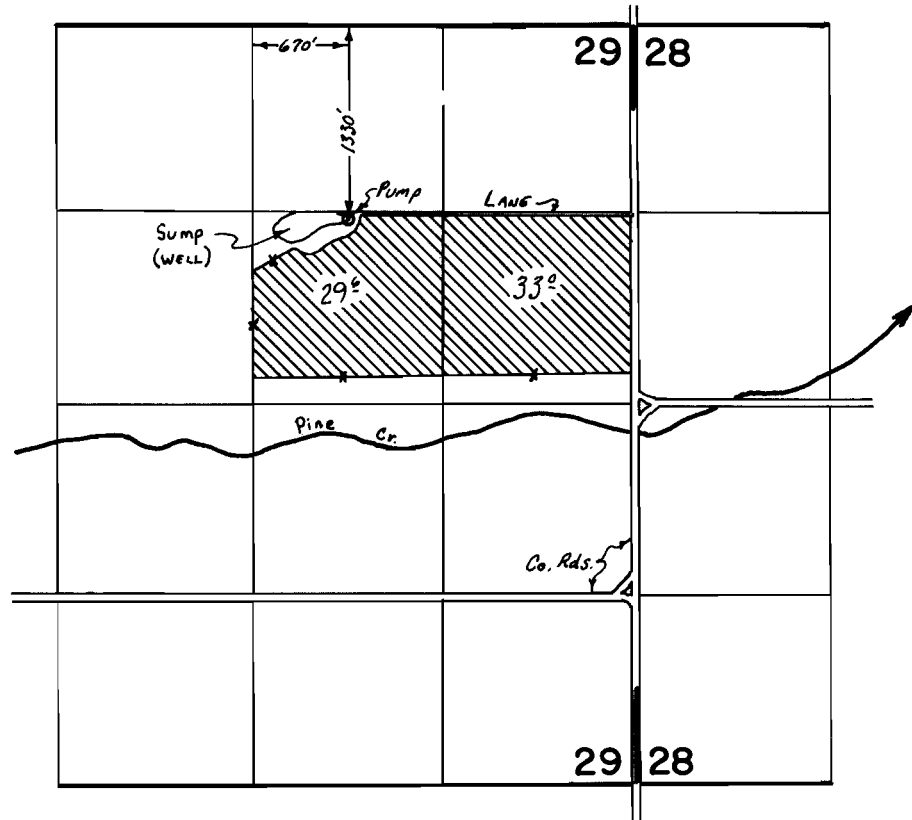

FINAL PROOF SURVEY
UNDER

Application No. G-5262 Permit No. G-4966
IN NAME OF

FRANK E. ADAMS

Surveyed Oct. 19 1972, by R.G. Mucken