


T.9S.R.39E.W.M.

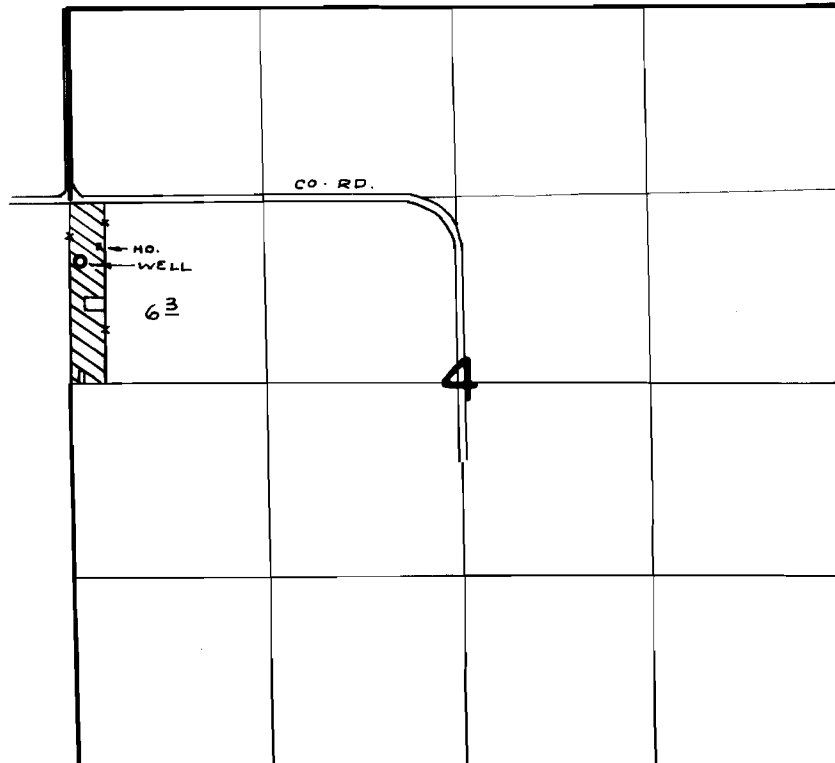

WELL LOC. 420' S. & 70' E. FROM N.W. COR. SW $\frac{1}{4}$ NW $\frac{1}{4}$ SEC. 4

FINAL PROOF SURVEY
UNDER

Application No. G-5215 Permit No. G-5003
IN NAME OF

GARY OLIVER WEYTHMAN

Surveyed OCT. 18, 1972, by R. MUCKEN