


T. 9 S. R. 3 8 E. W. M.

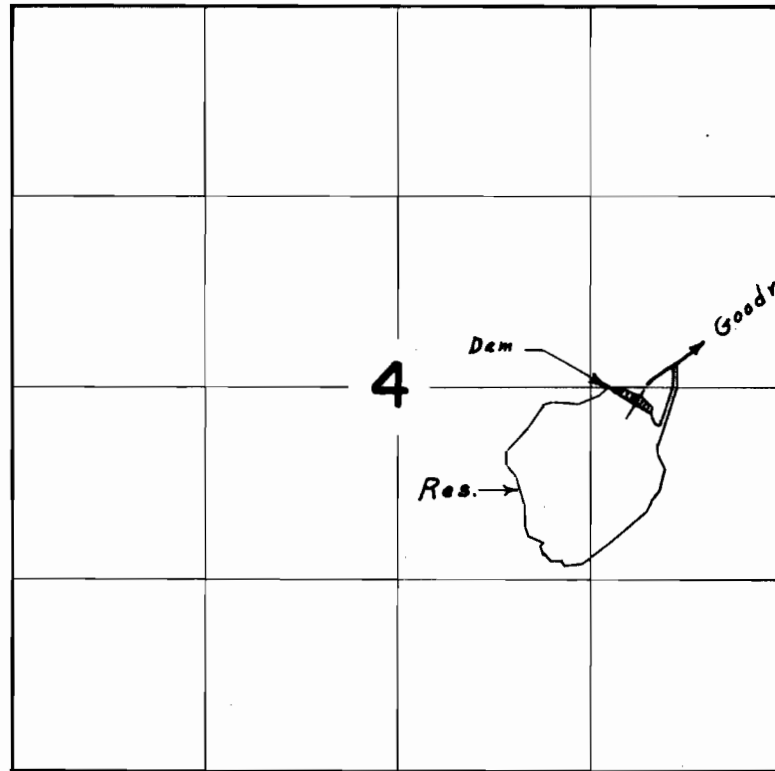

Div. Pt. located 120' S. & 1020' W. from E. $\frac{1}{4}$ Cor. Sec. 4

FINAL PROOF SURVEY
UNDER

Application No. R-34873 Permit No. R-2615
IN NAME OF

CITY OF BAKER

Surveyed Aug. 6, 1970, by L. E. Gould