


T.8S. R.46E. W.M.

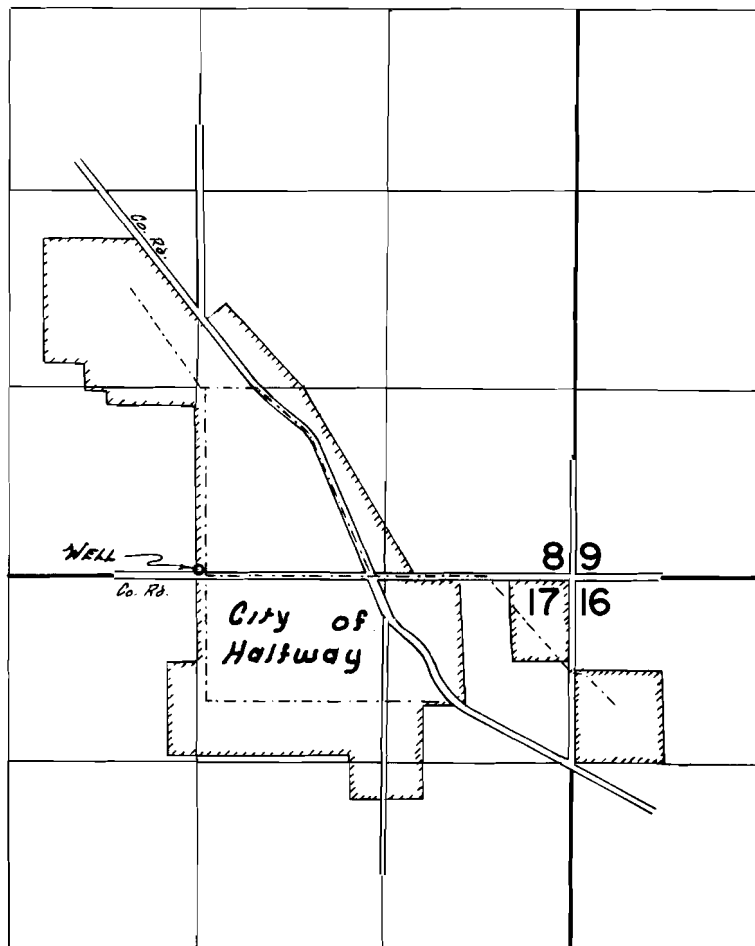

Well Loc: 30' N & 20' E FROM S 1/4 Co. Rd. Sec. 8

FINAL PROOF SURVEY
UNDER

Application No. G-3016 Permit No. G-2807
IN NAME OF

TOWN OF HALFWAY

Surveyed JUNE 24 1922, by R. G. MUCKER