


T.7S. R.45E. W.M.

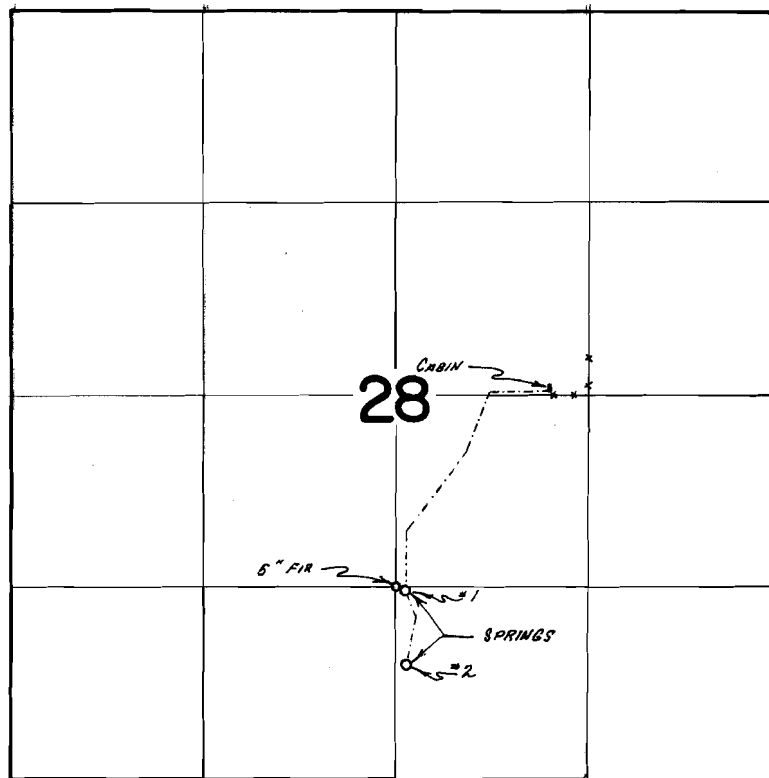

SPRING #1 Loc: 20' S. & 60' E FROM NW COR. SW 1/4 SE 1/4 SEC. 28
SPRING #2 Loc: 540' S. & 60' E FROM NW COR. SW 1/4 SE 1/4 SEC. 28

FINAL PROOF SURVEY
UNDER

Application No. 40116 Permit No. 22228
IN NAME OF

ROBERT D. THOMPSON

Surveyed JUNE 22 1972, by R.D. MURPHY