



T.9S. R.45E. W.M.

SE 1/4 NE 1/4
Section 34
T. 9 S. R. 45 E. W.M.

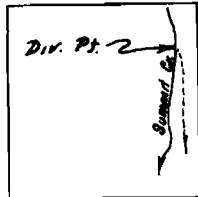

Div. Pt. Loc. 1030' N 1/4
160' W From E 1/4
Cor. Sec. 34

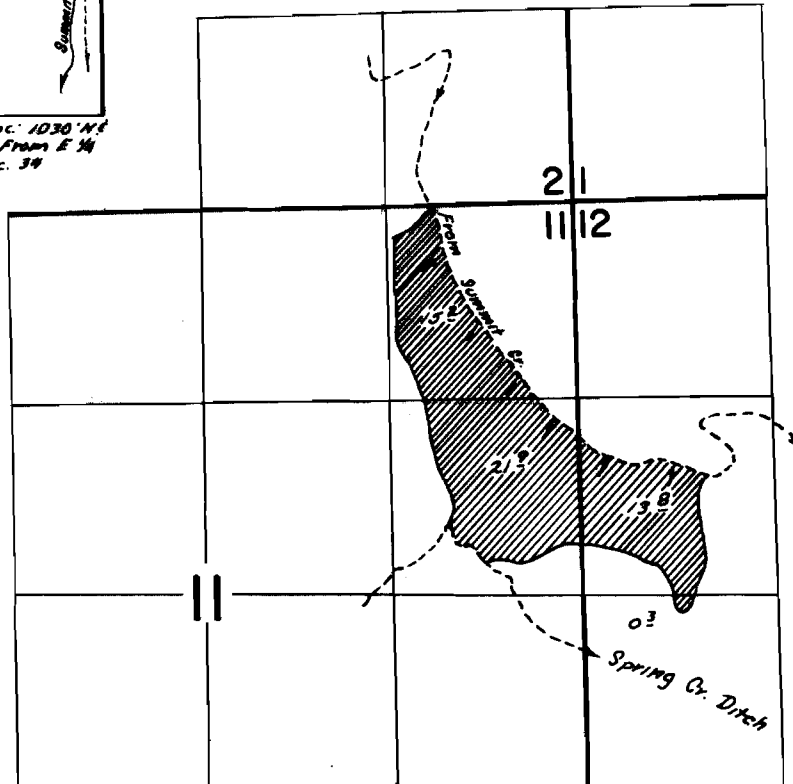

FINAL PROOF SURVEY UNDER

Application No. 41904 Permit No. 31407
IN NAME OF

OPEN STIRRUP RANCH

Surveyed June 21 1972, by R. A. Musken