


T.8S. R.46E. W.M.

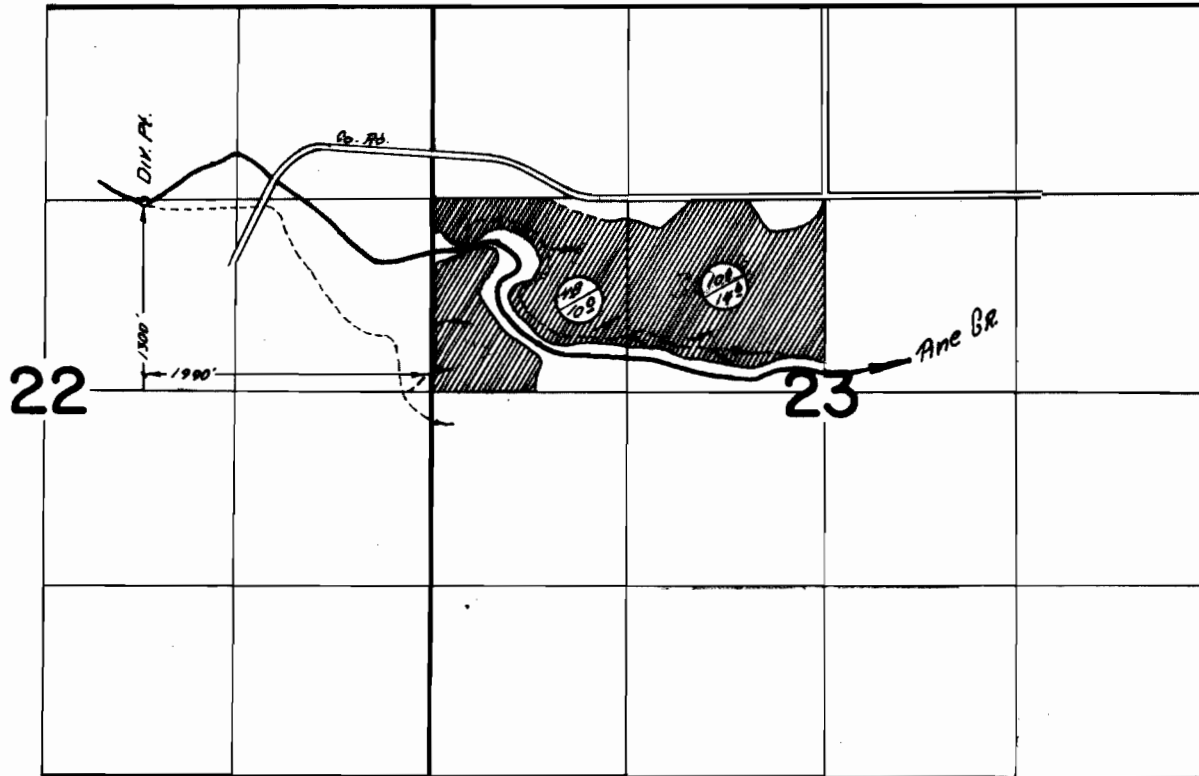

Primary
Supplemental

FINAL PROOF SURVEY
UNDER

Application No. 42422 Permit No. 31744
IN NAME OF

CHARLES R. GULICK

Surveyed June 22 1972, by R. B. MUCKEN