


T.9S. R.45E. W.M.

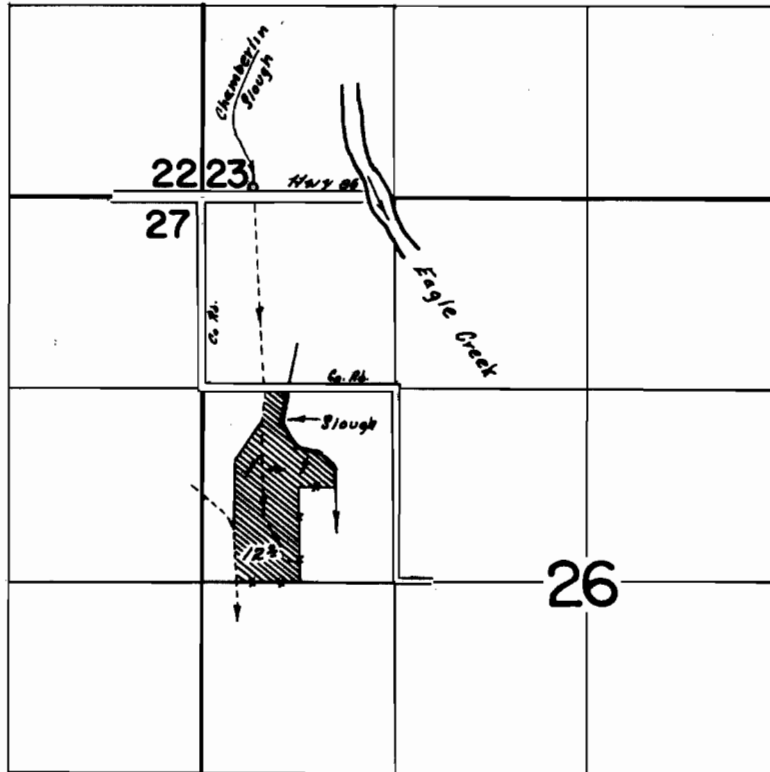

Div. Pt. Loc. 60' N & 330' E From SW Cor. Sec. 23

**FINAL PROOF SURVEY
UNDER**

Application No. 43424 Permit No. 22465
IN NAME OF

JACK M. CORNING

Surveyed June 20 1972, by R. E. Musken