T. 7 & 8 S. R. 46 E. W.M.

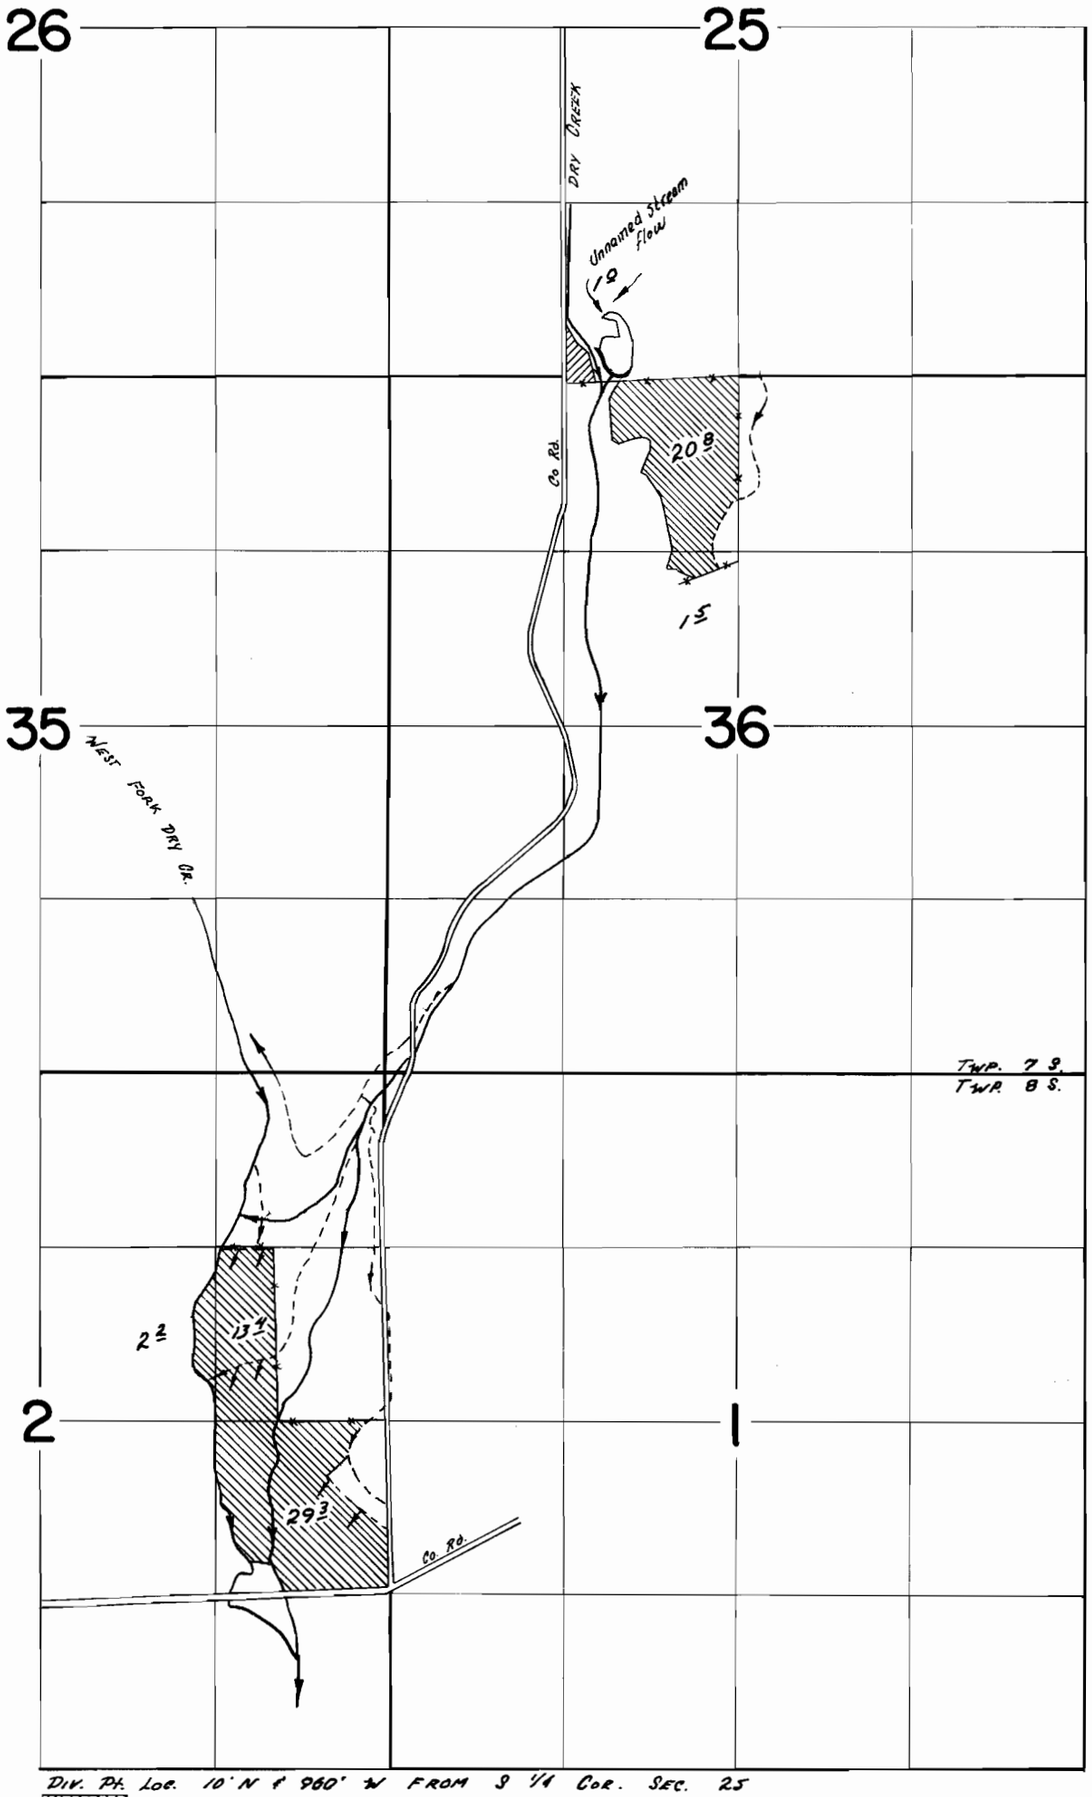

DIV. PT. LOC. 10' N & 960' W FROM S 1/4 COR. SEC. 25

Primary

Supplemental