


T.9S. R.39E. W.M.

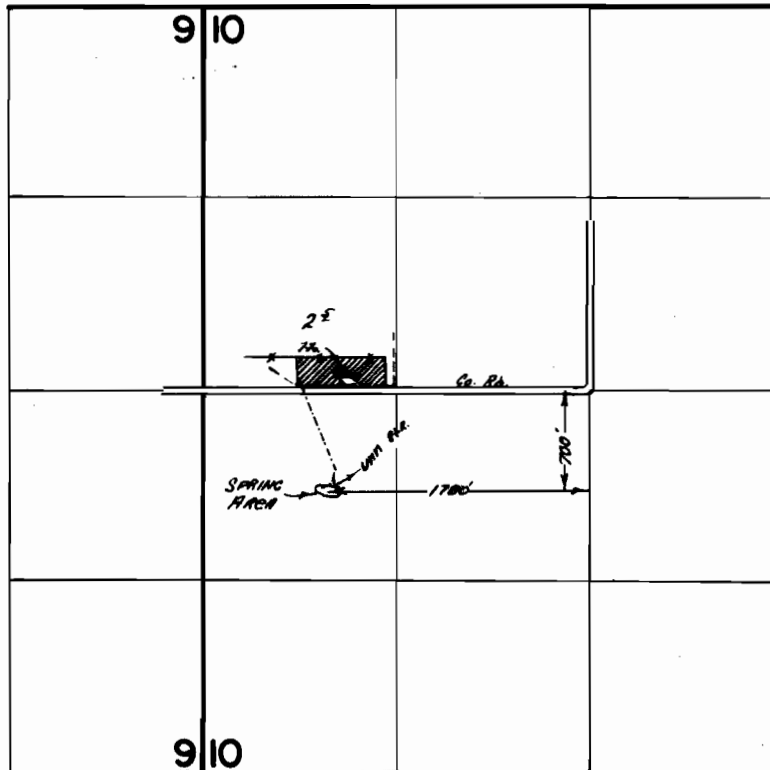

FINAL PROOF SURVEY
UNDER

Application No. 45212 Permit No. 34306
IN NAME OF

GEORGE M. BURNS

Surveyed Nov. 19 1972, by R. B. Mucken