


T.9&10S.R.26E.W.M.

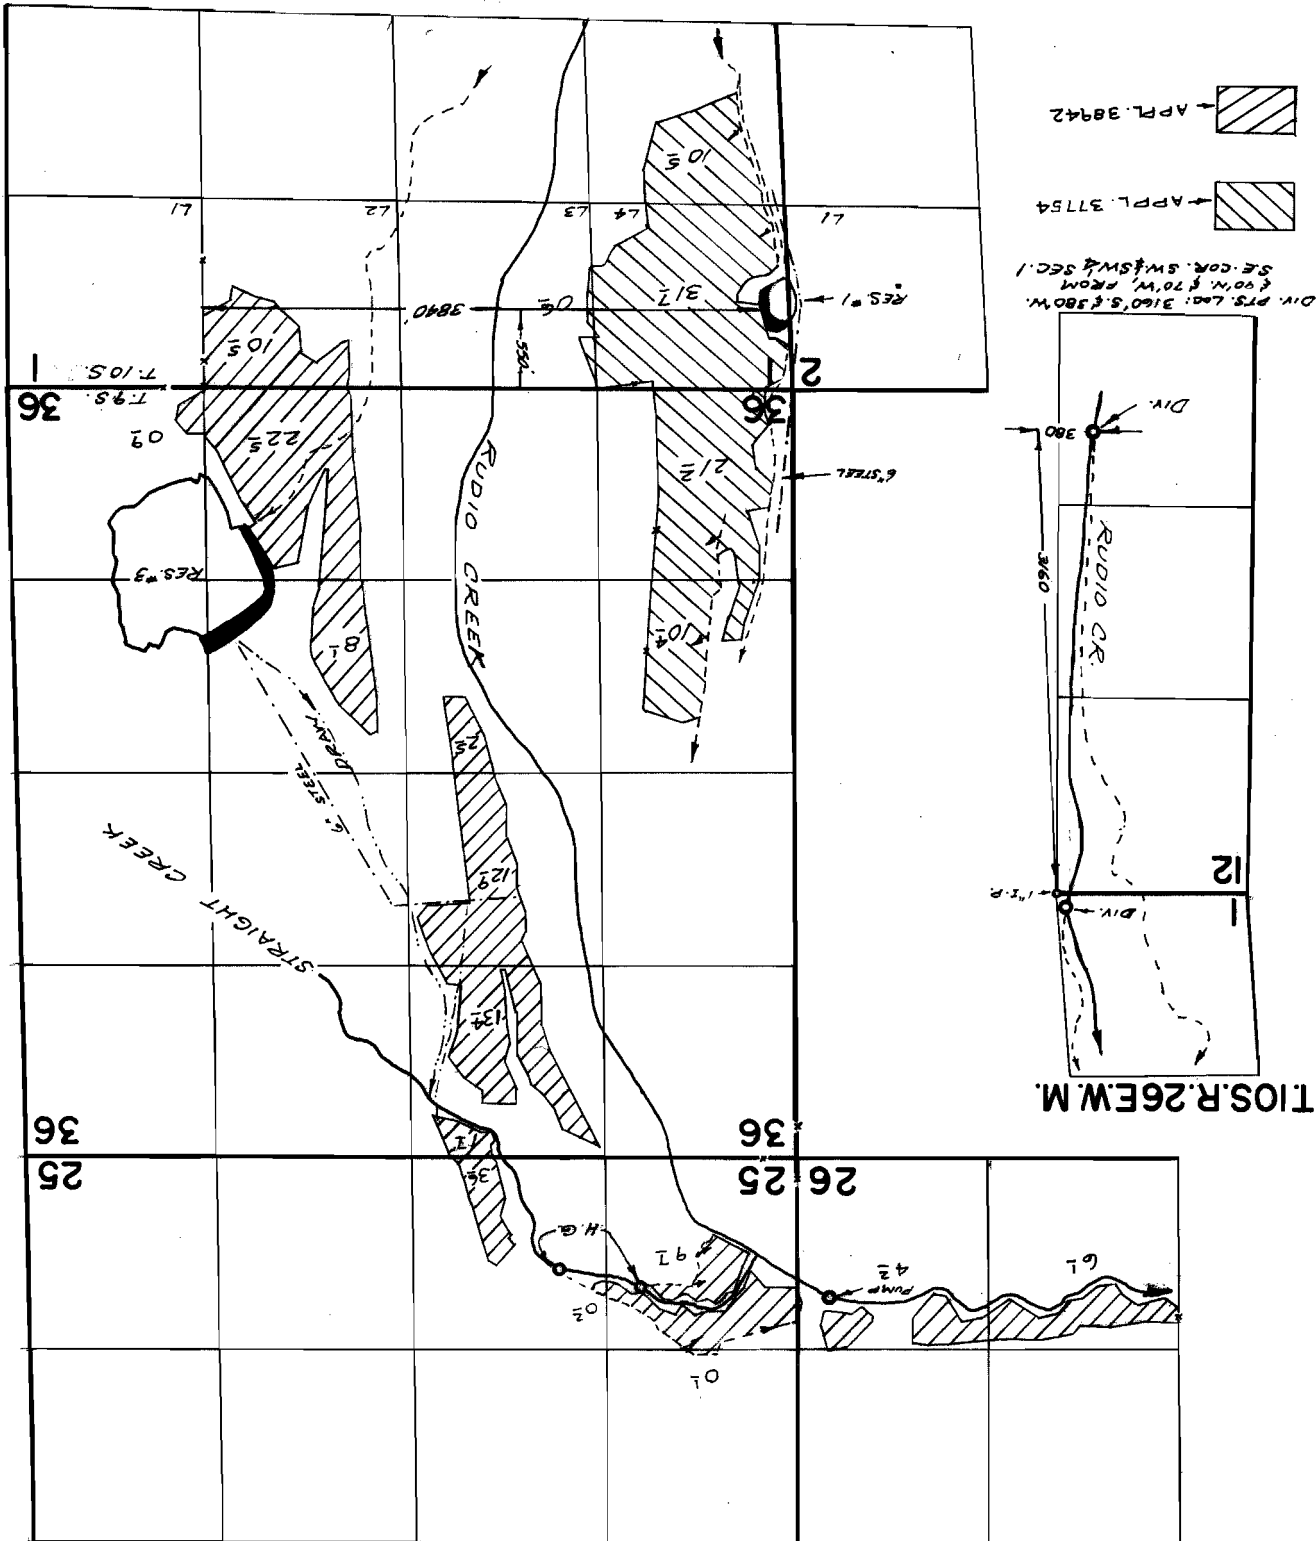

FINAL PROOF SURVEY

UNDER

Application No. 38942 Permit No. 23012
R-3677
R-3754
R-38942

IN NAME OF
RUDIO RANCH, INC.

Surveyed JULY 15, 1971 by R. MUCKEN