



T.9&10S.R.26E.W.M.

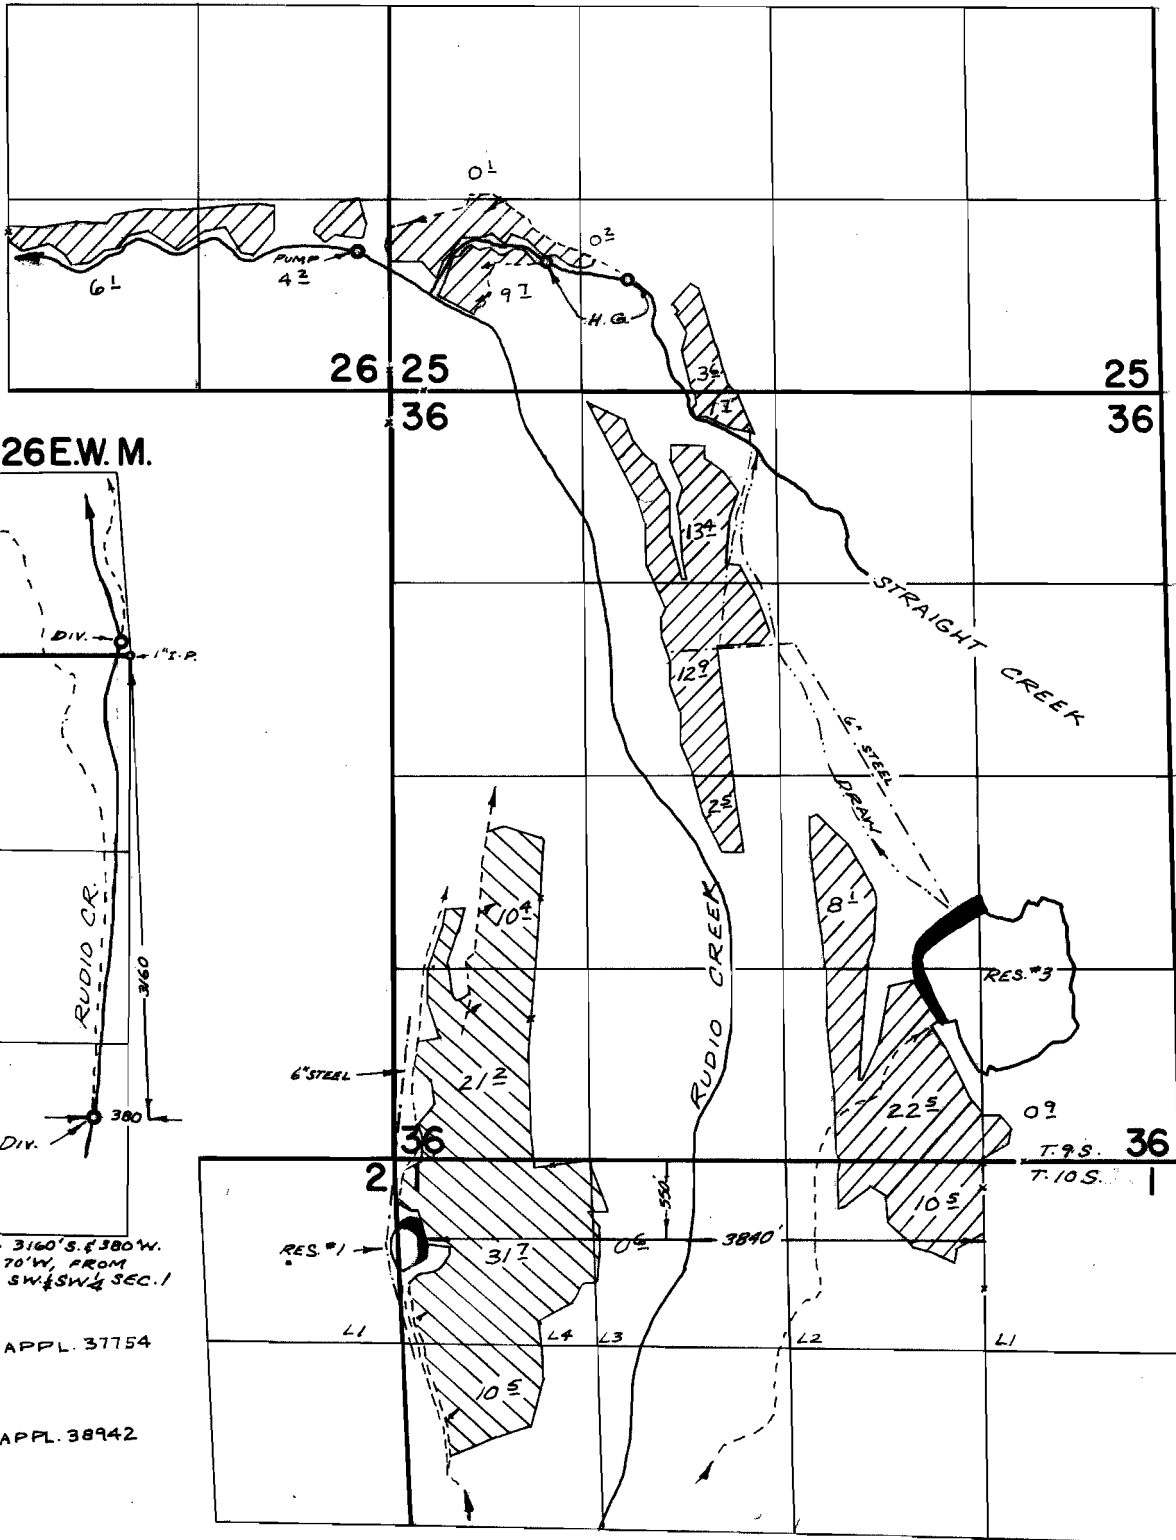

T.10S.R.26E.W.M.

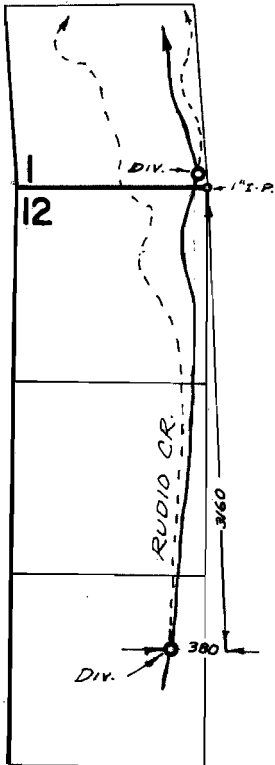

DIV. PTS. LOC: 3160'S. & 380'W.
 & 90'N. & 70'W, FROM
 S.E. COR. SW. & SW. SEC. 1

APPL. 37754

APPL. 38942

FINAL PROOF SURVEY

UNDER

Application No. *R-37752*
37754 Permit No. *R-3677*
R-38741 *29012*
38942 *R-3688*
29037

IN NAME OF

RUDIO RANCH, INC.

Surveyed JULY 13, 15, 16, 1971 by R. MUCKEN