


# T. 37S. R. 5 W. W.M.

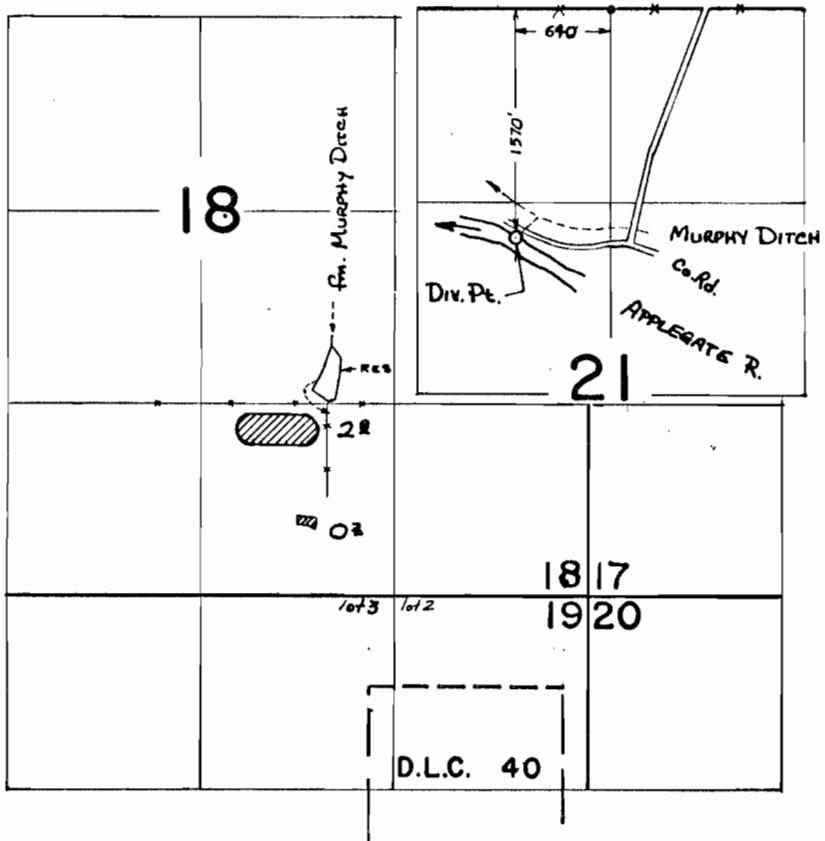

RES. DIV. PT: 20' N. & 450' W. FROM NE COR. S.W. 1/4 SE 1/4 SEC. 18

## FINAL PROOF SURVEY UNDER

R 37640                      R- 3270  
 Application No. 37641      Permit No. 28568  
 IN NAME OF

JOSEPHINE COUNTY SCHOOL DISTRICT

Surveyed May 22 1967, by J. Garner  
 15 APR.      70      D. BUELL