


T.6S., R.1E., W.M.

Use this map
for f.p. map
for transfer to be
made (change in
Pt. of Div.)

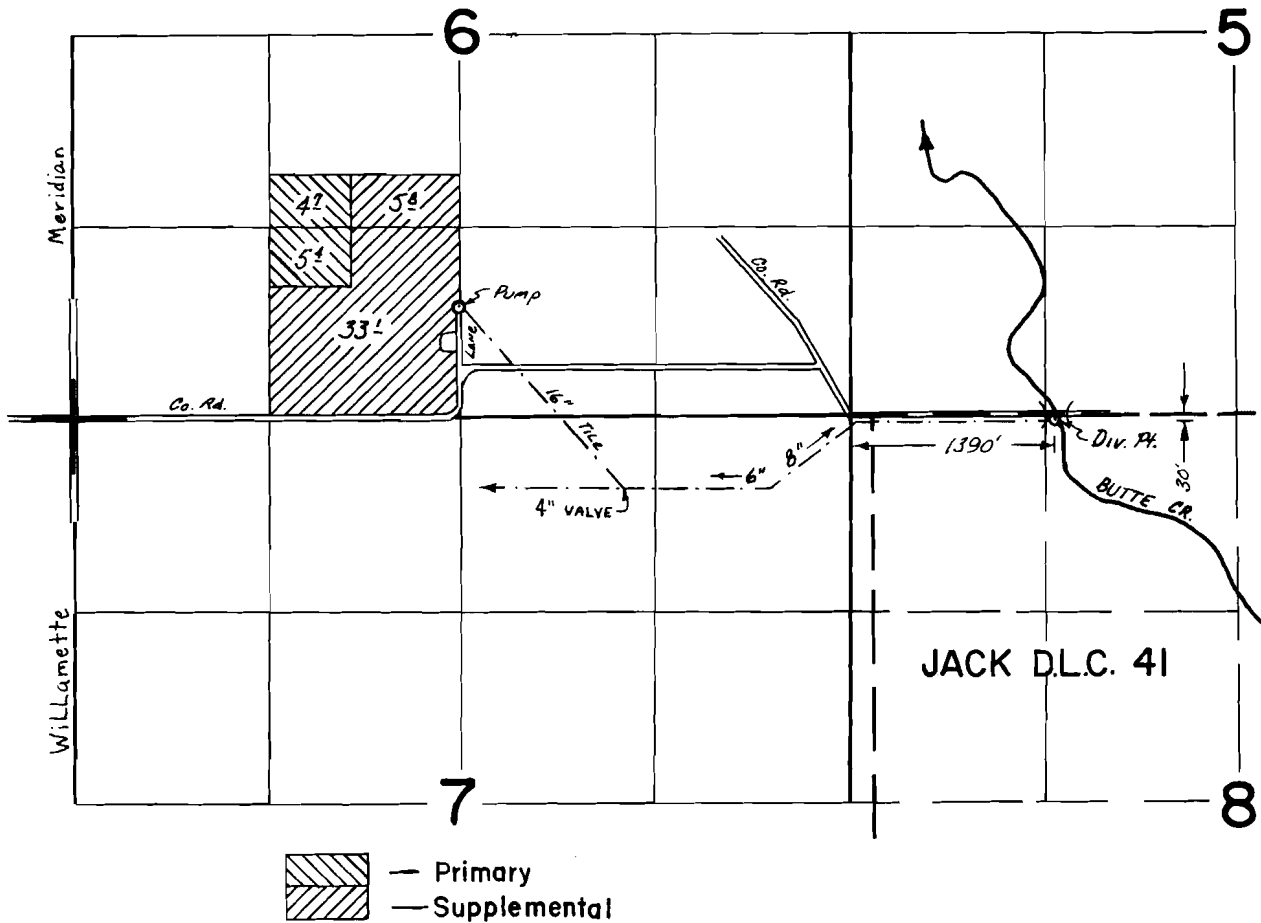


FINAL PROOF SURVEY
UNDER

Application No. 45055 Permit No. 33670
IN NAME OF

HERMAN GOSCHIE

Surveyed Oct. 13 1972, by R.G. Mucken

T.6S., R.1E., W.M.

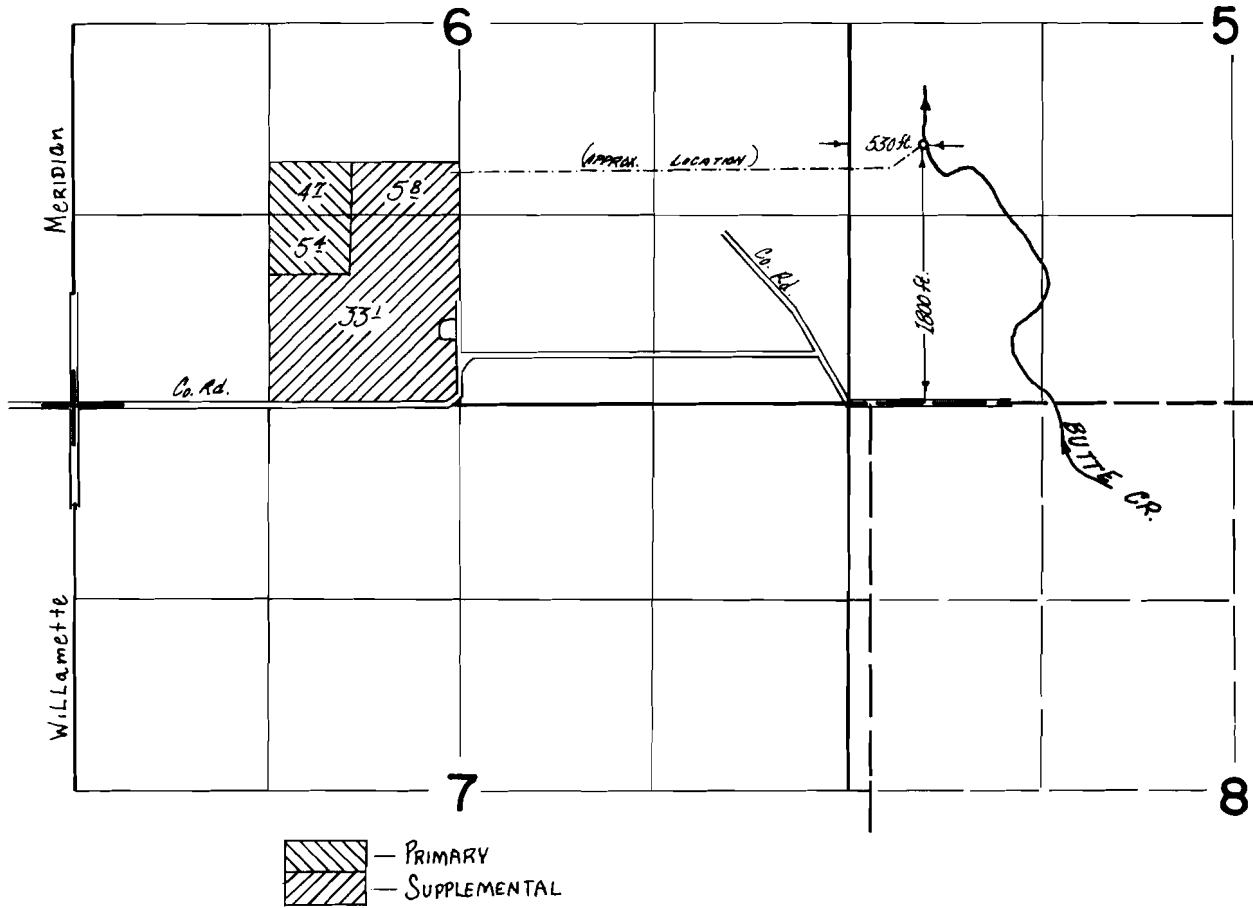

FINAL PROOF SURVEY
UNDER

Application No. 45055 Permit No. 33670
IN NAME OF

.....HERMAN GOSCHIE.....

Surveyed 13 Oct. 1972, by R. MUCKEN.....