


T. 6S.R. 3W. W.M.

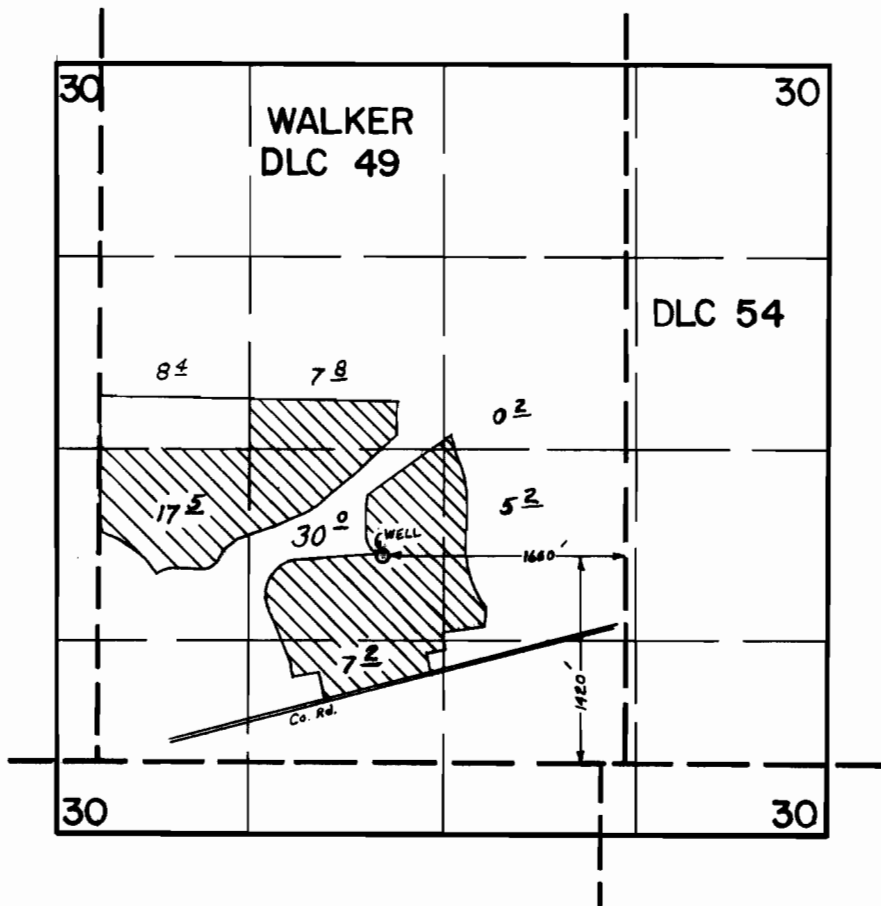

FINAL PROOF SURVEY UNDER

Application No. G-3124 Permit No. G-2916
IN NAME OF

VERNON H. GERBERDING

Surveyed NOV 13 1972, by L. GOULD