


# T. 8 S., R. 4 W., W.M.

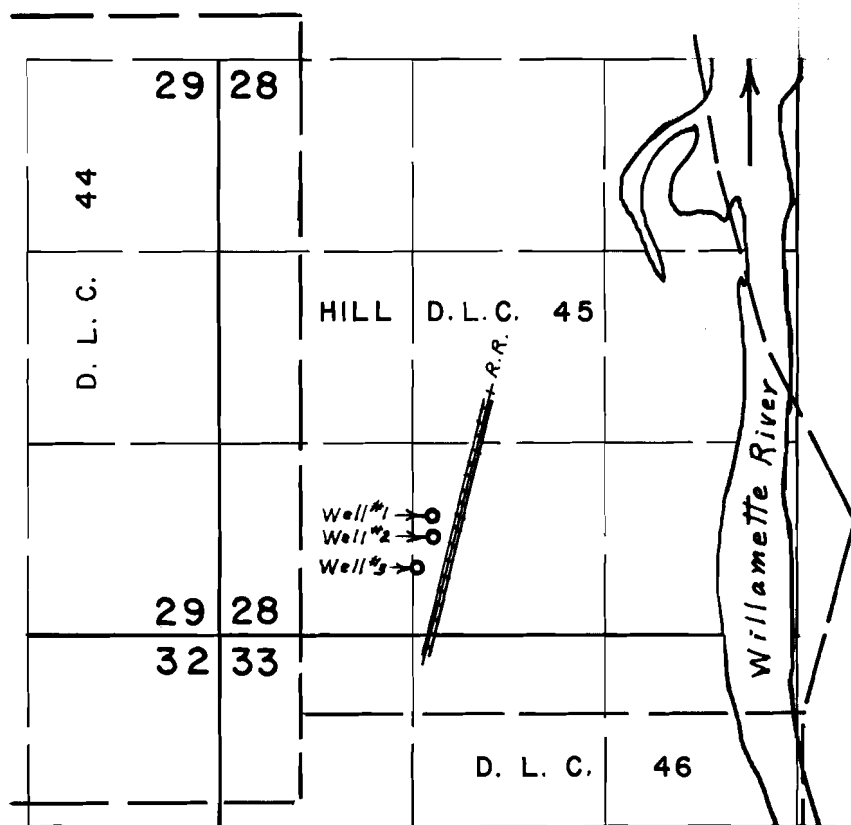

Wells located: #1, 1360' N. & 900' E.; #2, 1220' N. & 900' E.; #3, 1000' N. & 800' E.; All from S.W. Cor. Hill D.L.C. 45

## FINAL PROOF SURVEY UNDER

Application No. G-4332 Permit No. G-4087  
IN NAME OF

CITY OF MONMOUTH

Surveyed Nov. 13, 1972, by L. E. Gould