


T. 7 S. R. 3 W. W. M.

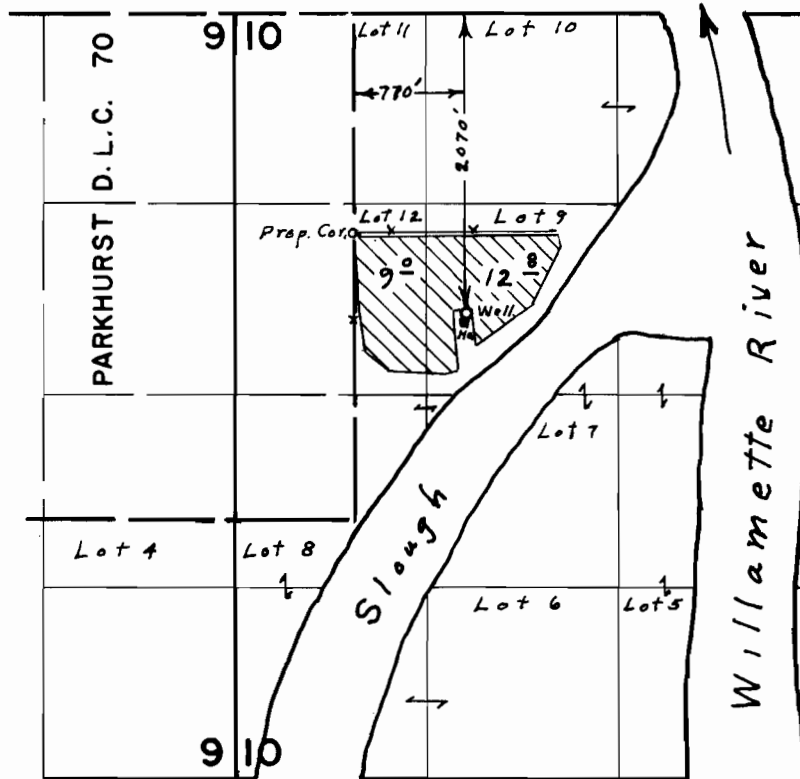

**FINAL PROOF SURVEY**  
UNDER

Application No. G-4808 Permit No. G-4532  
IN NAME OF

B & B FARMS INC.

Surveyed April 5, 1972, by L. E. Gould