


T. 6 S. R. 3 W. W. M.

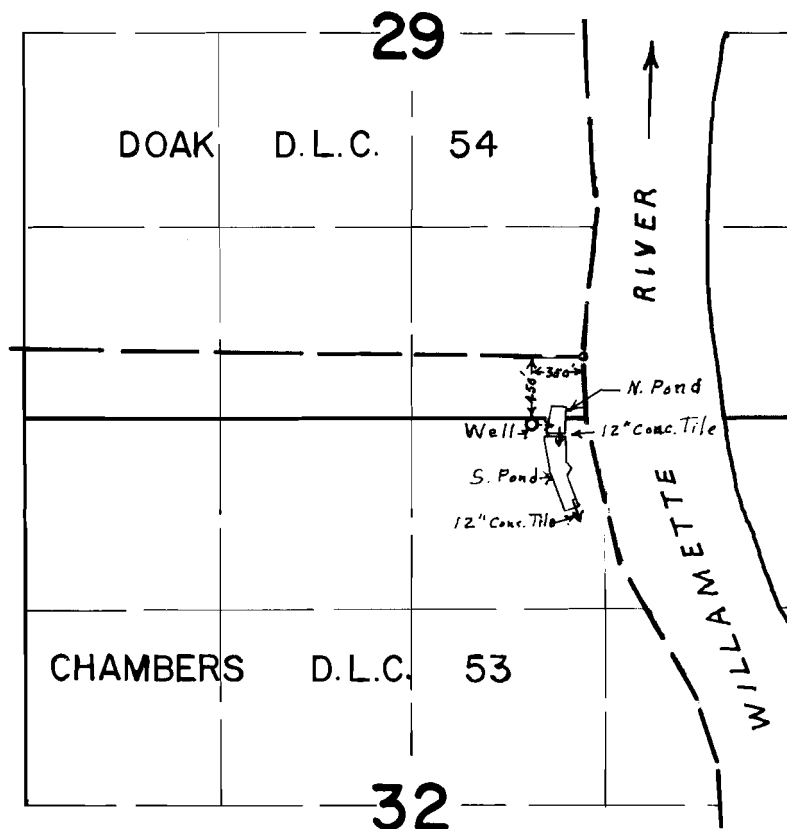

FINAL PROOF SURVEY UNDER

Application No. G-5308 Permit No. G-4824
IN NAME OF

FIRST BAPTIST CHURCH

Surveyed April 28, 1972, by L. E. Gould