


T. 7 S. R. 5 W. W. M.

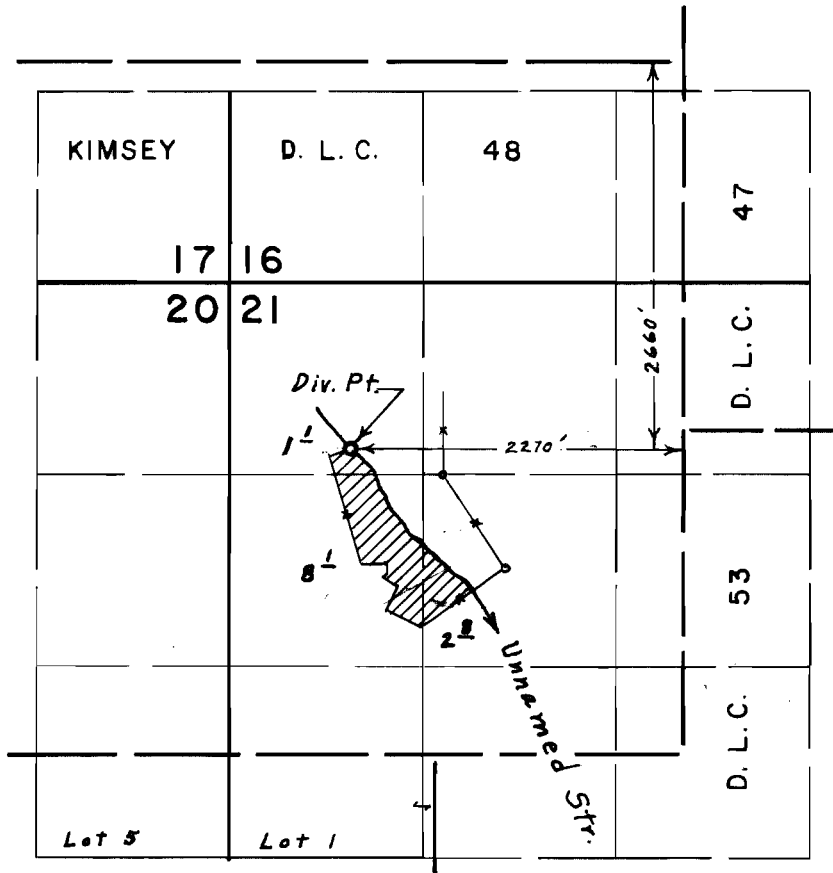

FINAL PROOF SURVEY UNDER

Application No. 37606 Permit No. 28046
IN NAME OF

FRANK R. ROBINSON

Surveyed April 7, 1972, by L. E. Gould