


T. 6 S. R. 7 W. W.M.

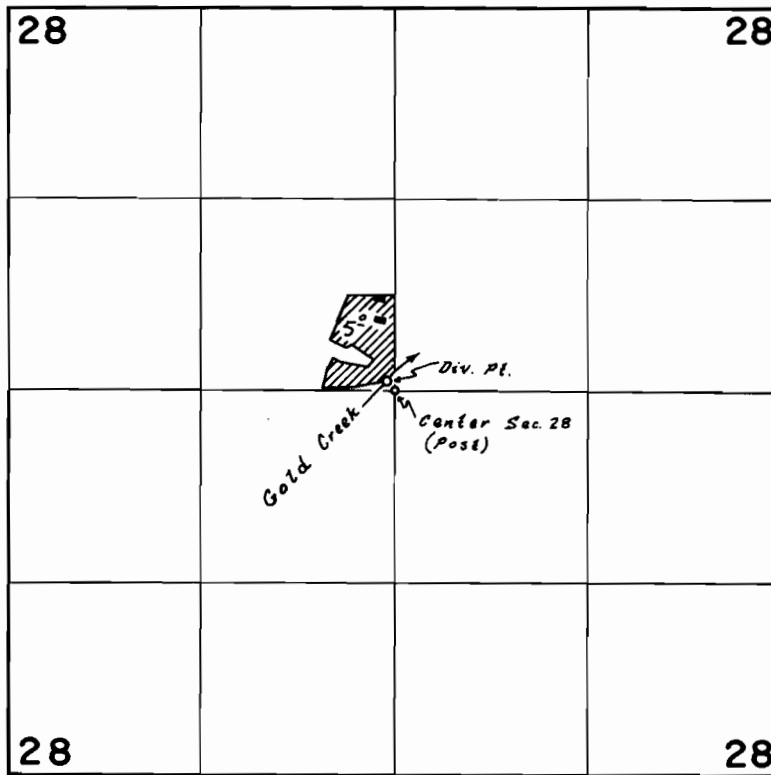

Div. Pt. loc. 75' N. & 65' W. from Center Sec. 28

FINAL PROOF SURVEY
UNDER

Application No. 42587 Permit No. 31820
IN NAME OF
Dan Hill

Surveyed 14 June 1972, by L.E. Gould