


T. 7 S. R. 6 W. W.M.

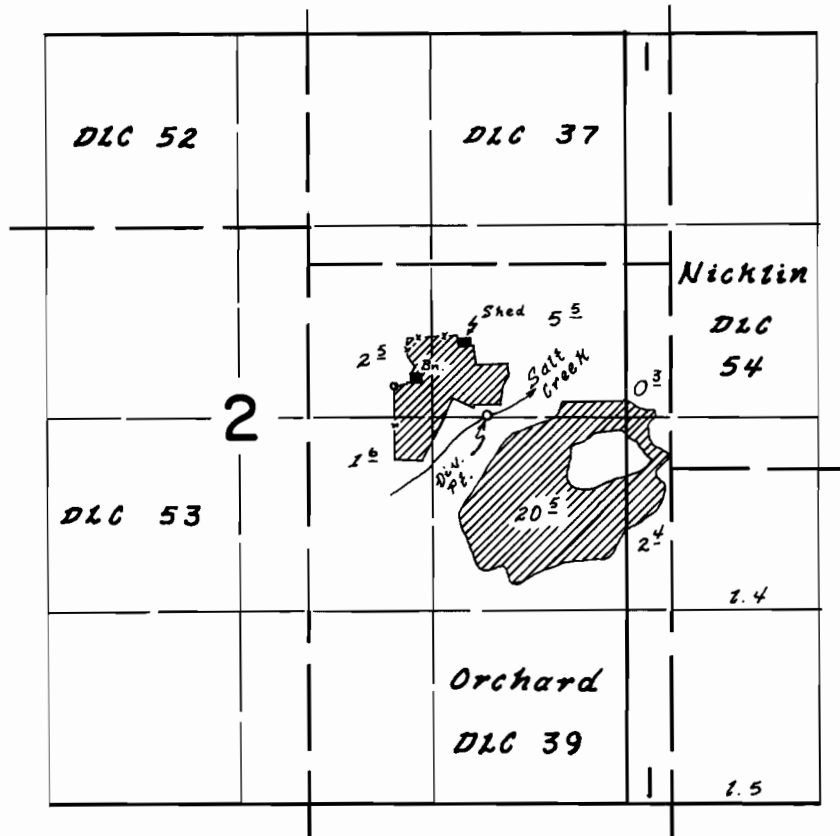

Div. Pt. loc. 360' N. & 1260' W. from S.W. Cor. Nicklin DLC 54

**FINAL PROOF SURVEY**  
UNDER

Application No. 42716 Permit No. 31915  
IN NAME OF

*Henry A. & Rose B. Englehaupt*

Surveyed 29 Sept. 1972, by L.E. Gould