


T. 6 S., R. 4 W., W.M.

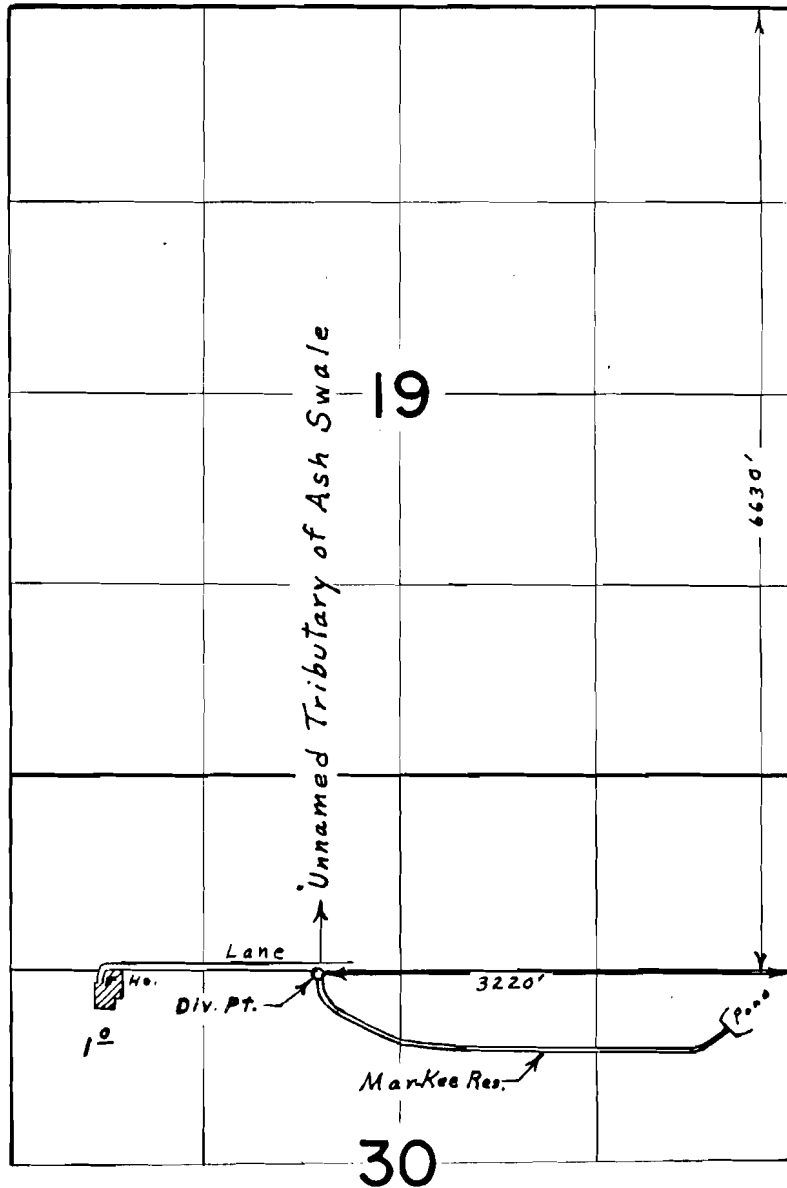

FINAL PROOF SURVEY
UNDER

R-43115 R-4968
Application No. 43116 Permit No. 32372
IN NAME OF

WM. H. McKEE

.....
Surveyed May 17, 1972, by L. E. Gould.