


T.6 S., R.4 W., W.M.

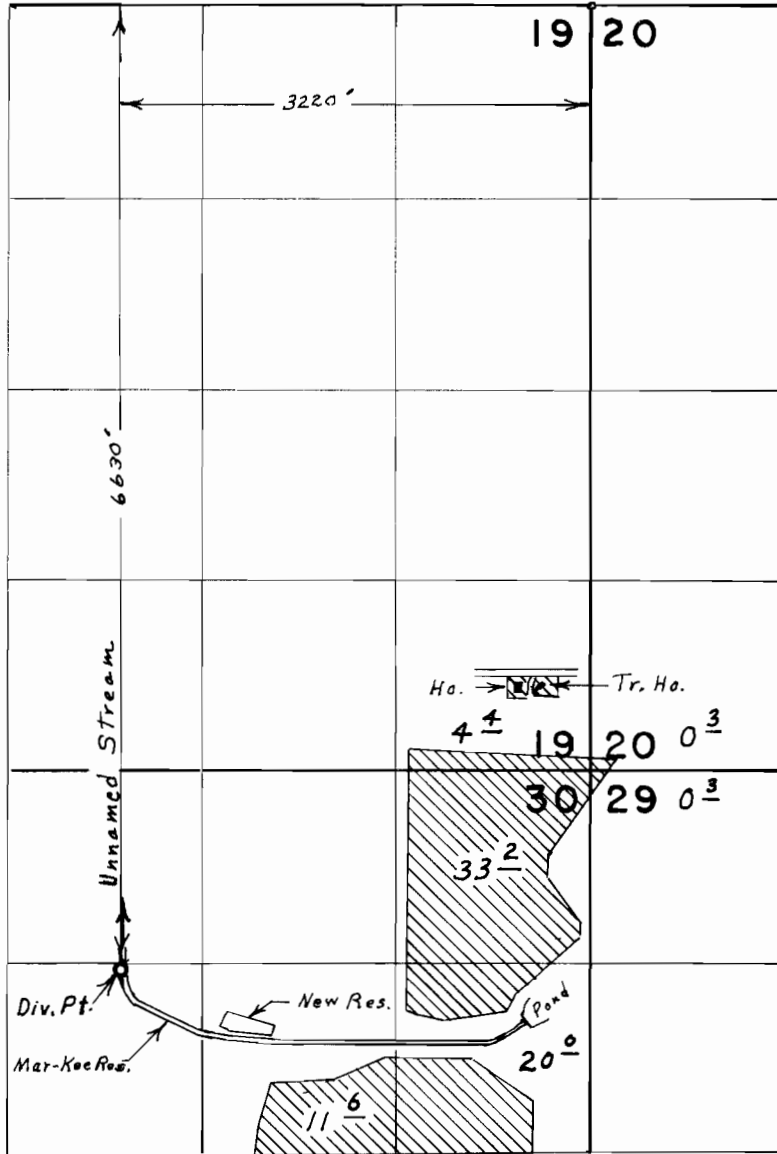

FINAL PROOF SURVEY UNDER

Application No. 43117 Permit No. 32373

IN NAME OF

GLEN R. MARTIN

Surveyed May 15, 1972, by L. E. Gould