


T. 6 S., R. 5 W., W.M.

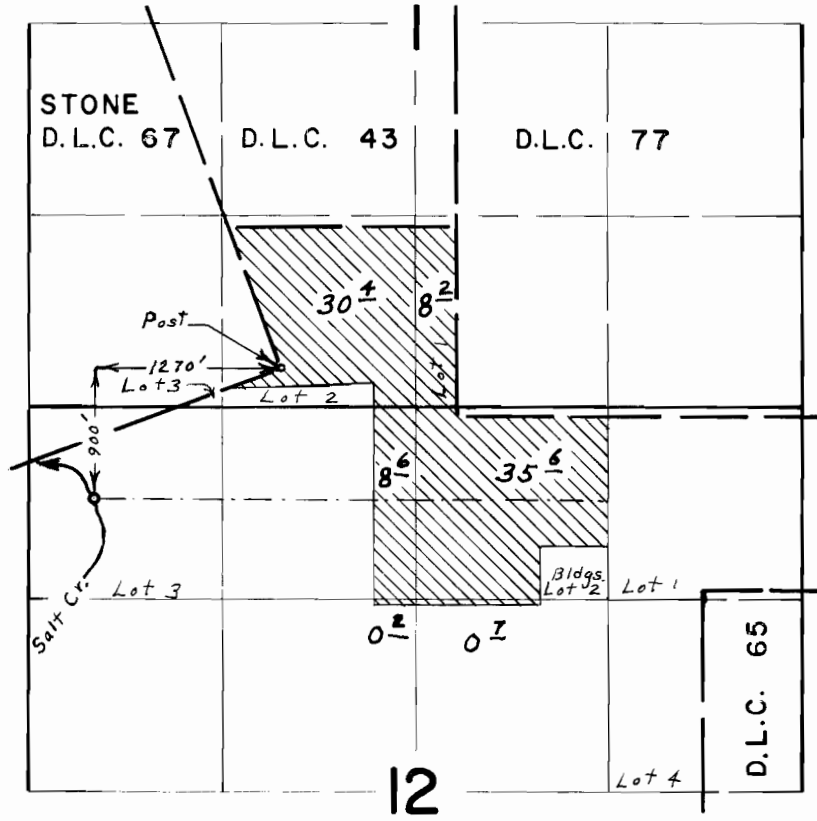

FINAL PROOF SURVEY UNDER

Application No. 43350 Permit No. 32401
IN NAME OF

JOE J. DAUENHAUER

Surveyed April 28, 1972, by L. E. Gould