


T. 7 S. R. 4 W. W. M.

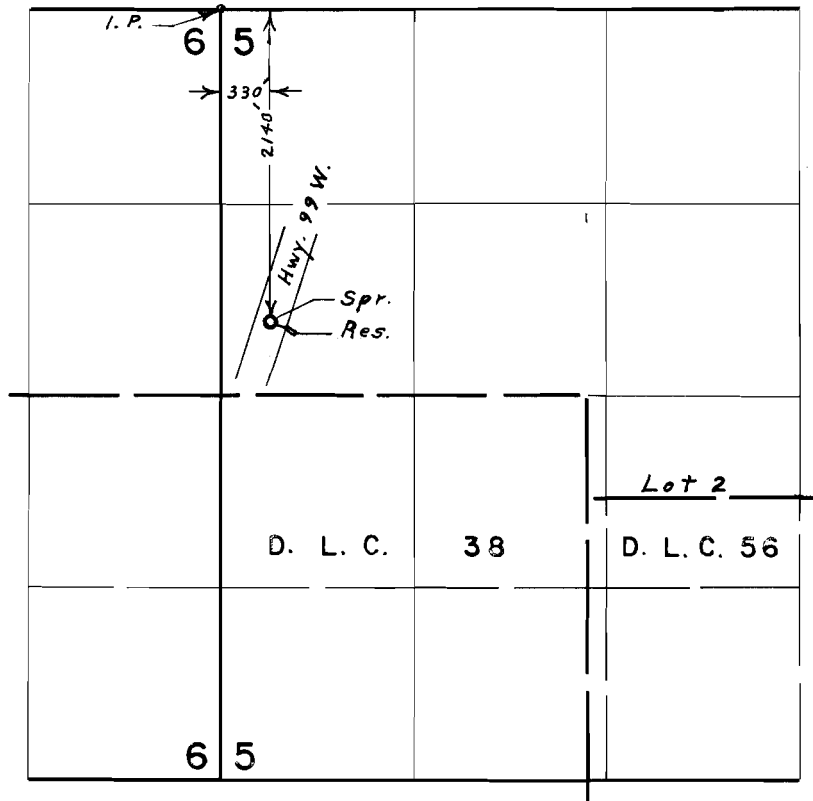

FINAL PROOF SURVEY UNDER

Application No. 43718 Permit No. 32678
IN NAME OF

MERTON COVILLE

Surveyed April 5, 1972, by L. E. Gould