


T. 6 S. R. 3 W. W. M.

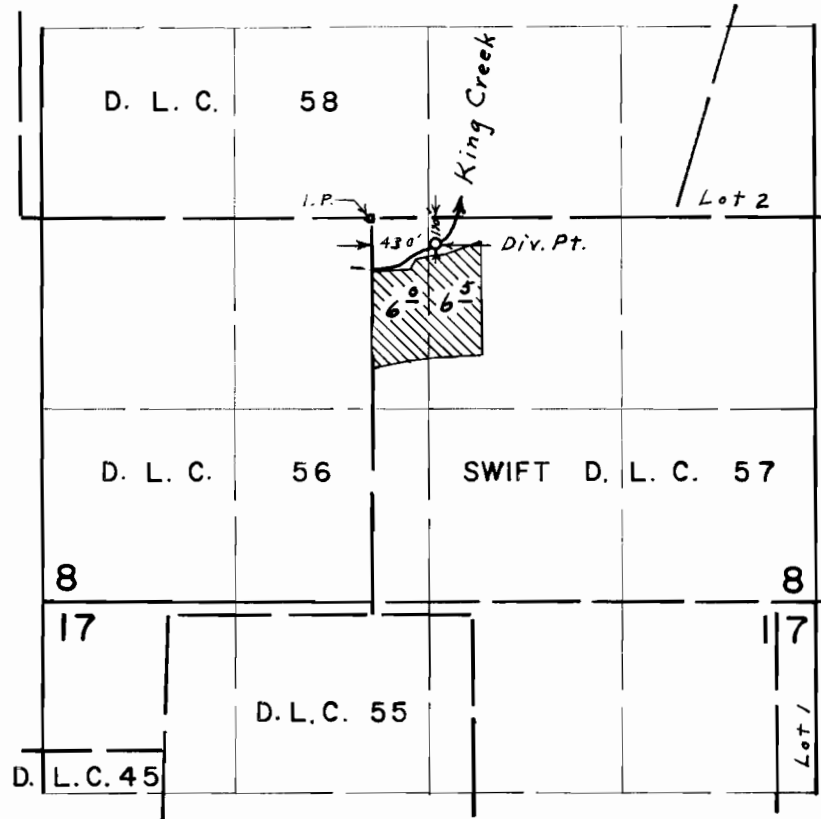

**FINAL PROOF SURVEY**  
UNDER

Application No. 44967 Permit No. 33610  
IN NAME OF

GARY W. DAUM

Surveyed April 25, 1972, by L. E. Gould